


T.15S.R.1E.W.M.

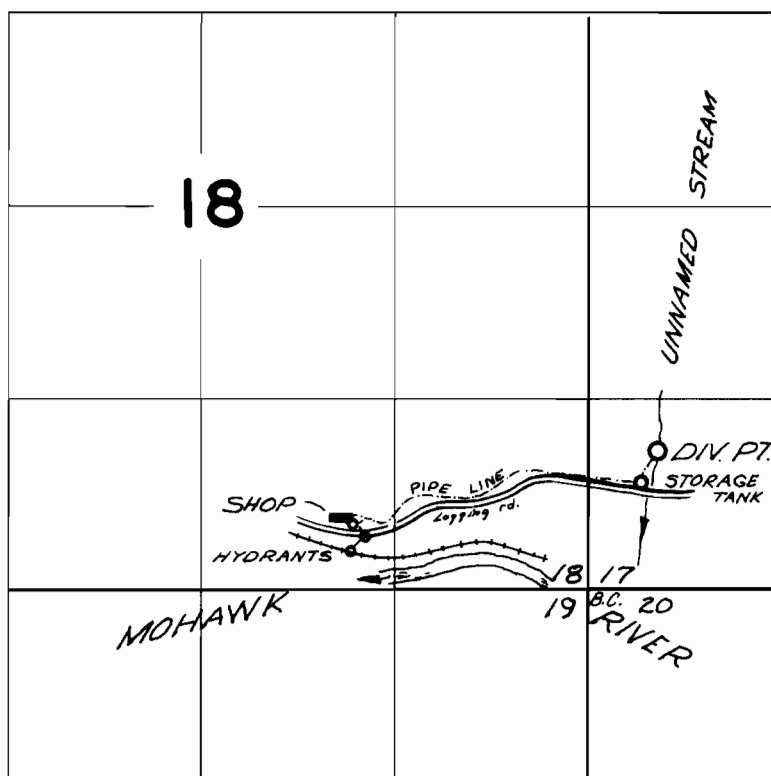

Div. pt. located 950 ft. N and 470 ft. E. from
the SW corner of Section 17

FINAL PROOF SURVEY
UNDER

Application No. 37459 Permit No. 27888
IN NAME OF

WEYERHAEUSER COMPANY

Surveyed May 3 1966, by V. GARNER

1966 - A