


T.18S. R.2&3 W. W.M.

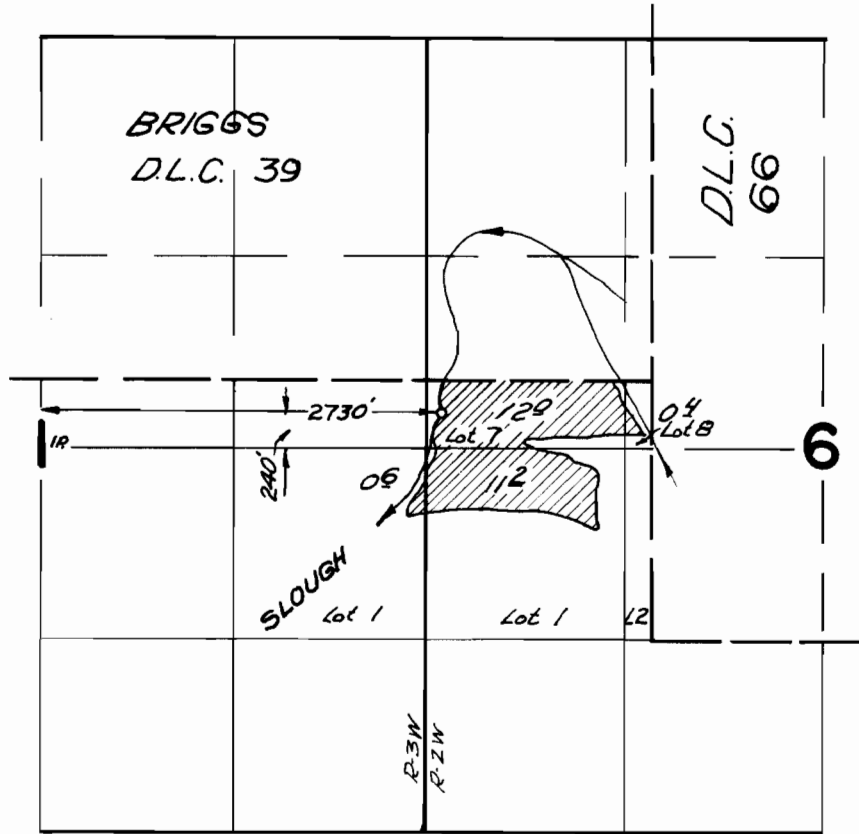

**FINAL PROOF SURVEY**  
UNDER

Application No. 37447 Permit No. 27940  
IN NAME OF

DONALD V. SAUL

Surveyed May 4 1966, by V. Garner