


T.16 & 17S. R. 5W. W.M.

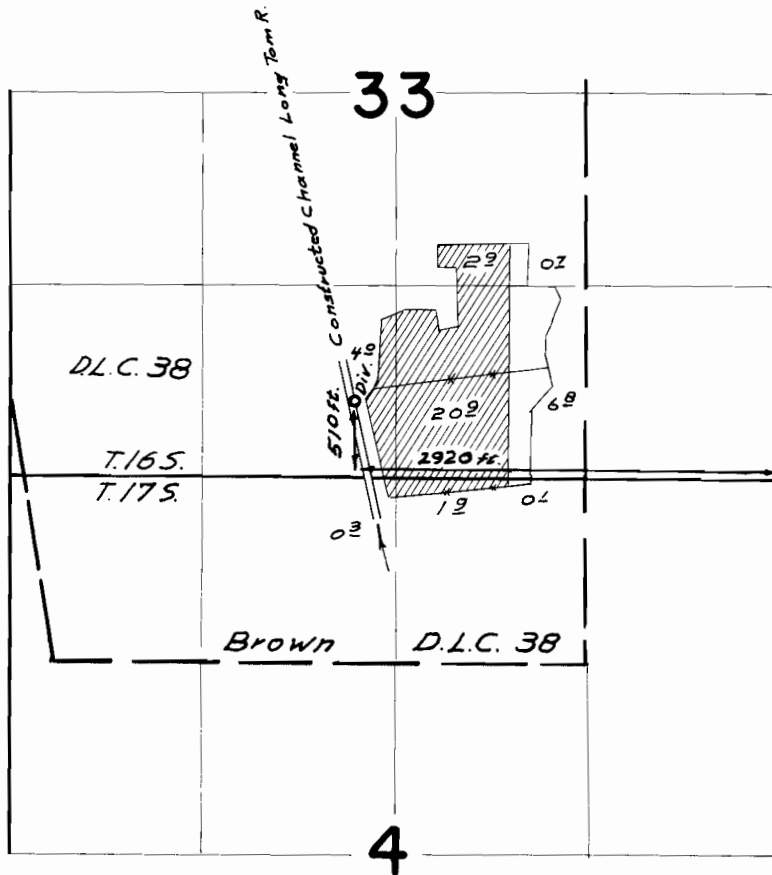

FINAL PROOF SURVEY
UNDER

Application No. 37922 Permit No. 28244
IN NAME OF

Dwane K. Richardson

Surveyed May 18 1966, by W. J. Ruppert