


T.17 S. R.1 W. W.M.

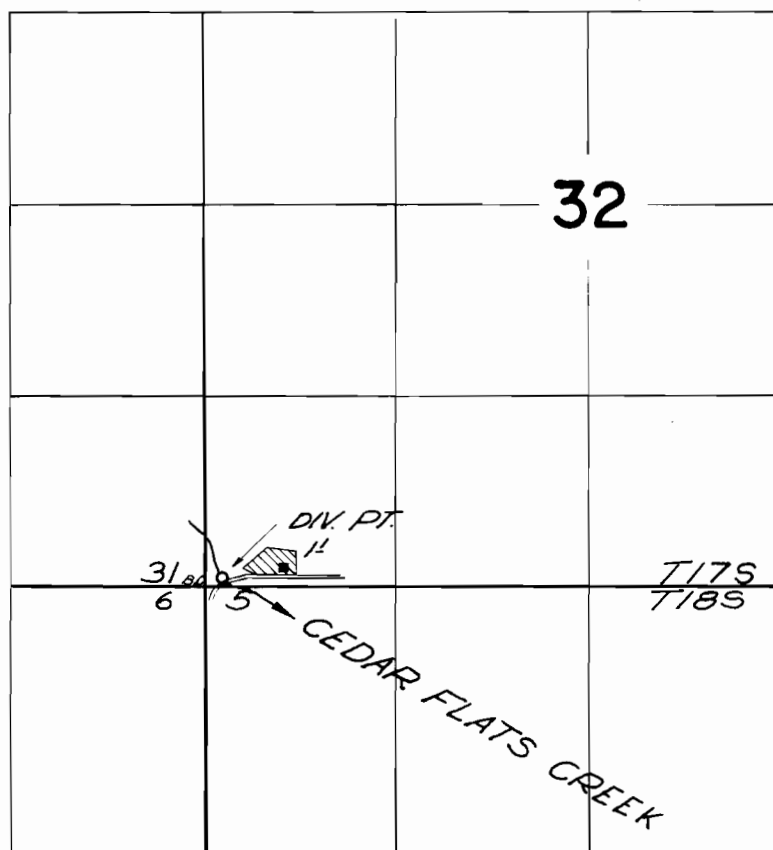

Div. Pt. located 60 ft N. & 110 ft E. from the SW cor. Sec. 32

FINAL PROOF SURVEY
UNDER

Application No. 38321 Permit No. 28530
IN NAME OF

ERIK and DORIS PAJUNEN

Surveyed May 3 1966, by V. GARNER