


T.18S.R.2&3W.W.M.

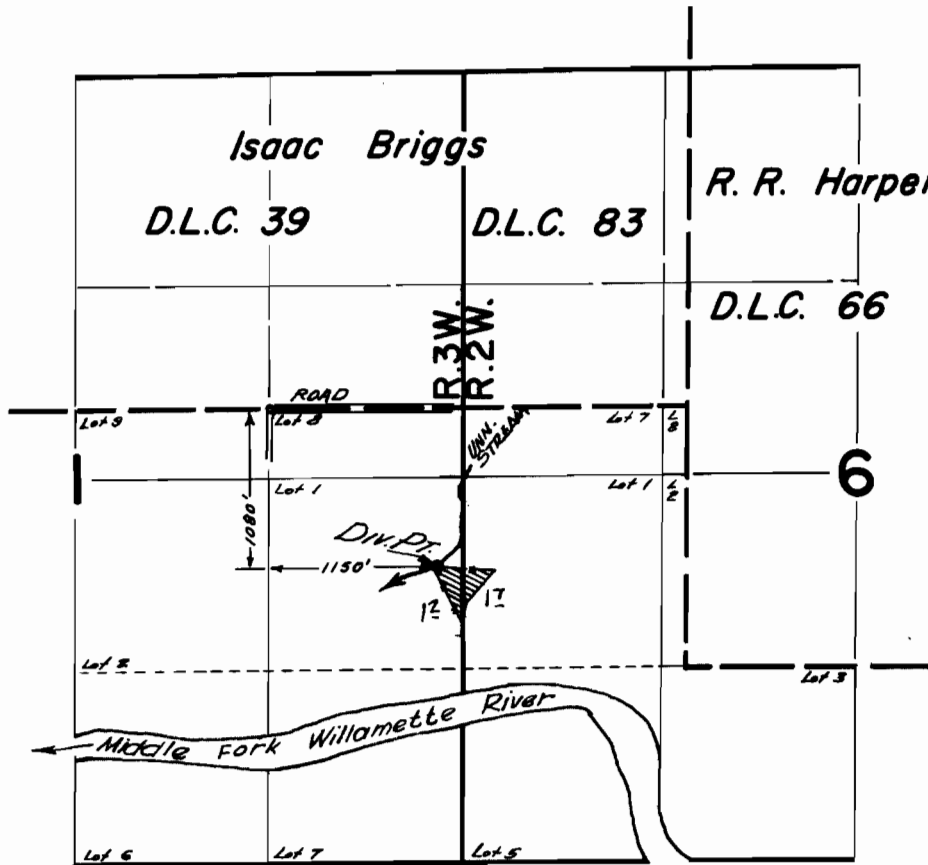

FINAL PROOF SURVEY
UNDER

Application No. 39169..... Permit No. 29136.....
IN NAME OF

W. J. & MOLLY K. REEVES

Surveyed *May 5* 1965, by *D. Jackson*