


T.17S.R.4W.W.M.

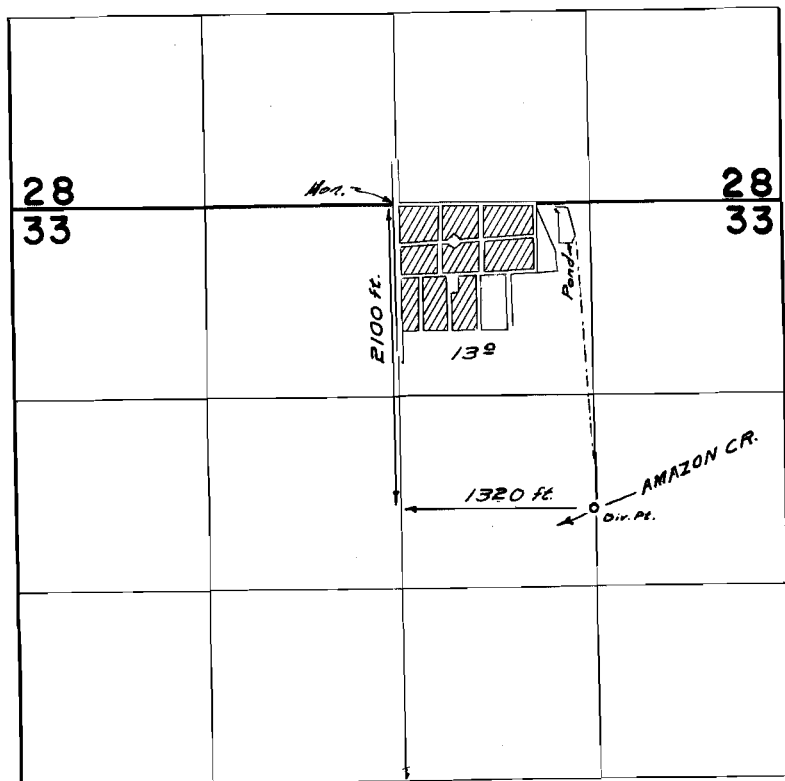

**FINAL PROOF SURVEY**  
UNDER

Application No. 40284 Permit No. 30029  
IN NAME OF

WEST LAWN MEMORIAL PARK

Surveyed May 19 1956, by W.J. Ruppert