


T.17S. R.3W. W.M.

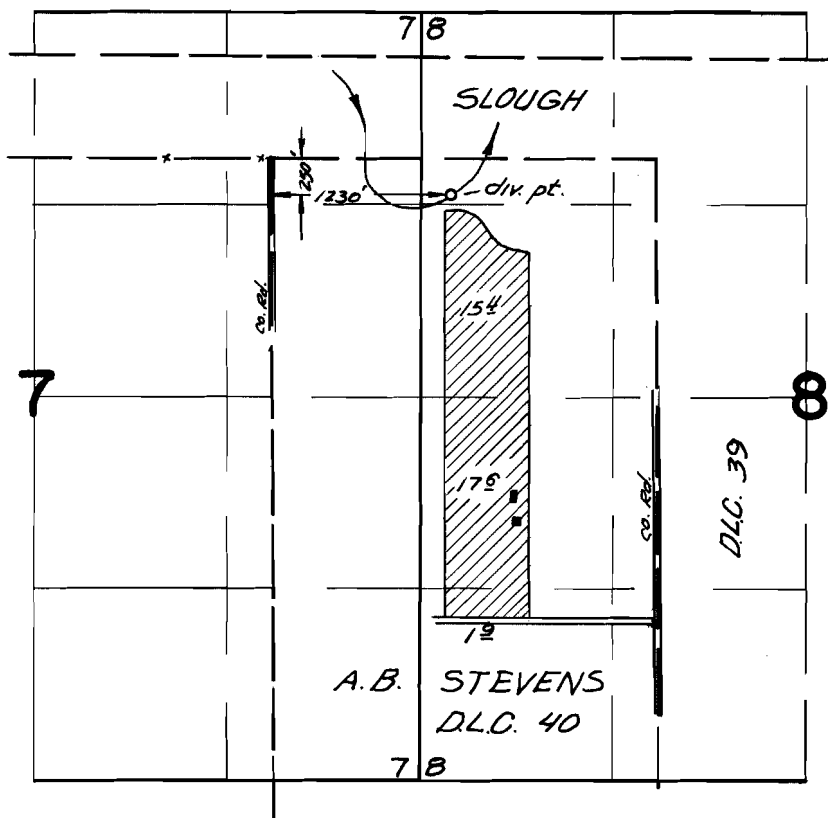

FINAL PROOF SURVEY UNDER

Application No. 40542 Permit No. 30216
IN NAME OF

GERALD B. SAUNDERS

Surveyed May 13 1966, by V. Garner