


T. 10 & 11 S. R. 3 W. W.M.

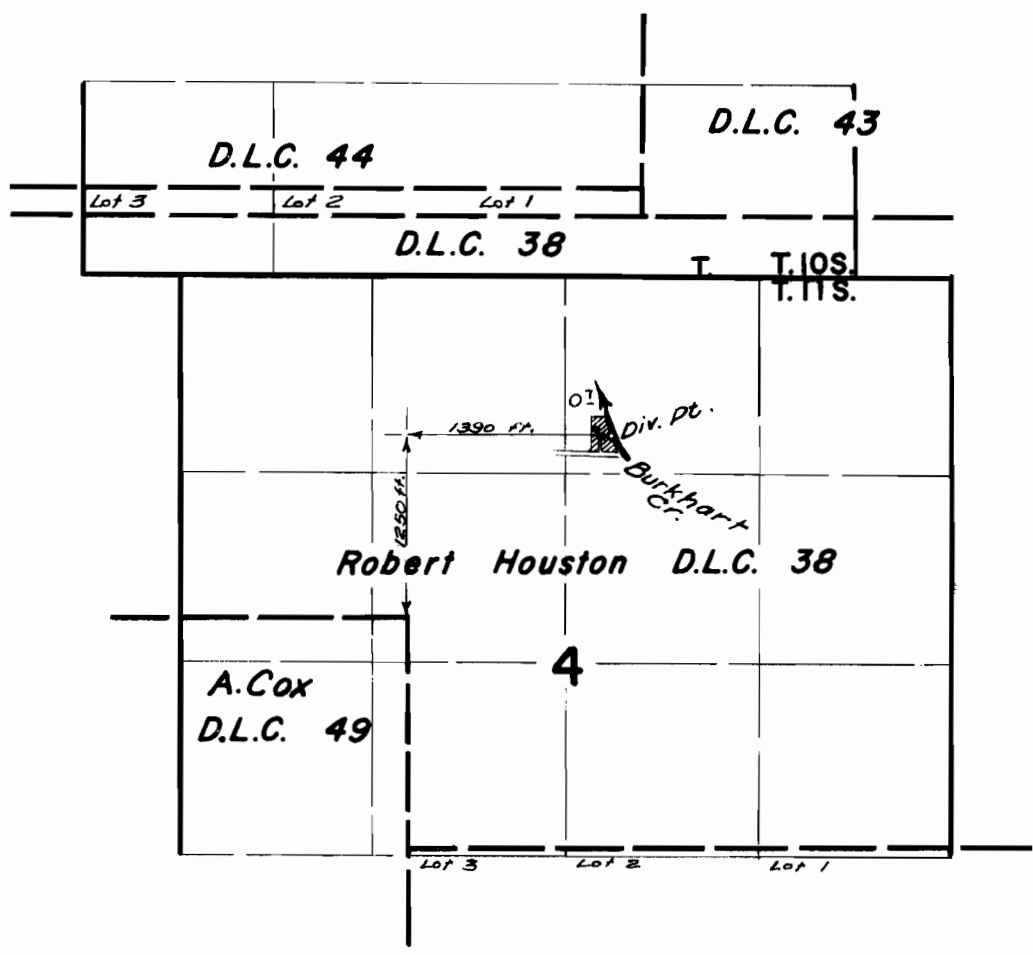

FINAL PROOF SURVEY
UNDER

Application No. 37499... Permit No. 27947...
IN NAME OF

DAN PHILLIPS

Surveyed April 6, 1966, by *R. Jackson*