


T.13 & 14 S. R. 40 E. W.M.

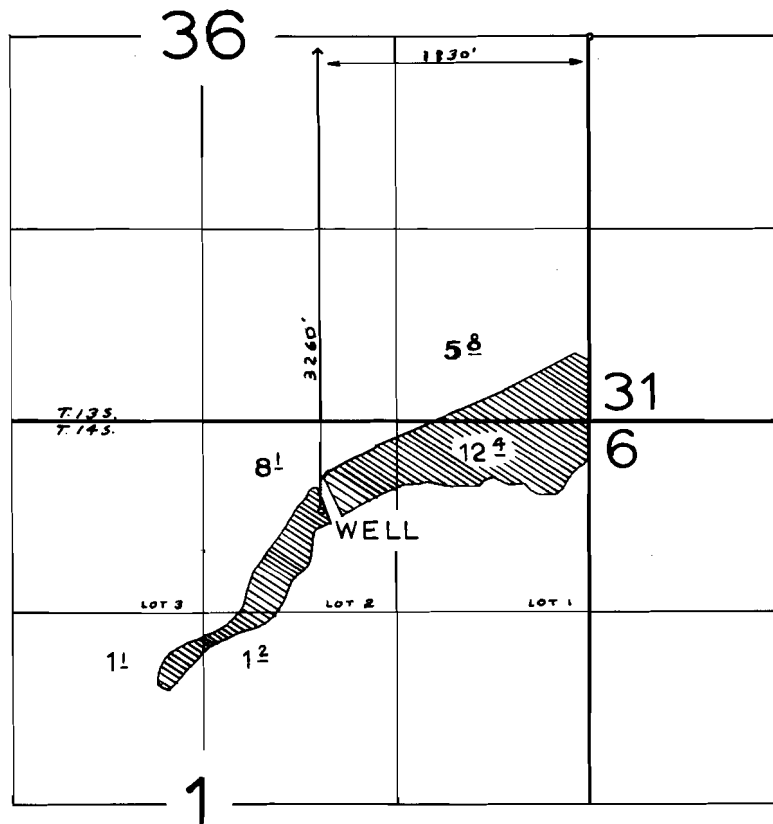

FINAL PROOF SURVEY
UNDER

Application No. G-2041 Permit No. G-1876
IN NAME OF

ROBERT S. LANGMACK

Surveyed OCT. 27, 1966, by FELFERING