


T.18S.R.46E.W.M.

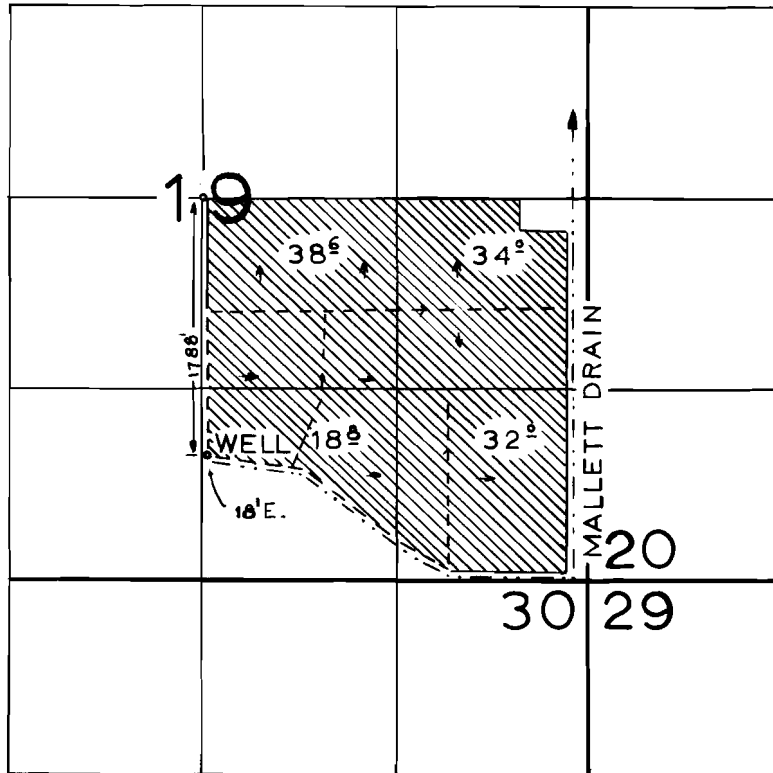

**FINAL PROOF SURVEY**  
UNDER

Application No. G-2052 Permit No. G-1884  
IN NAME OF

DONALD WOOD

Surveyed OCT. 30 1967, by F.ELFERING