


T.18S.R. 46 E.W.M.

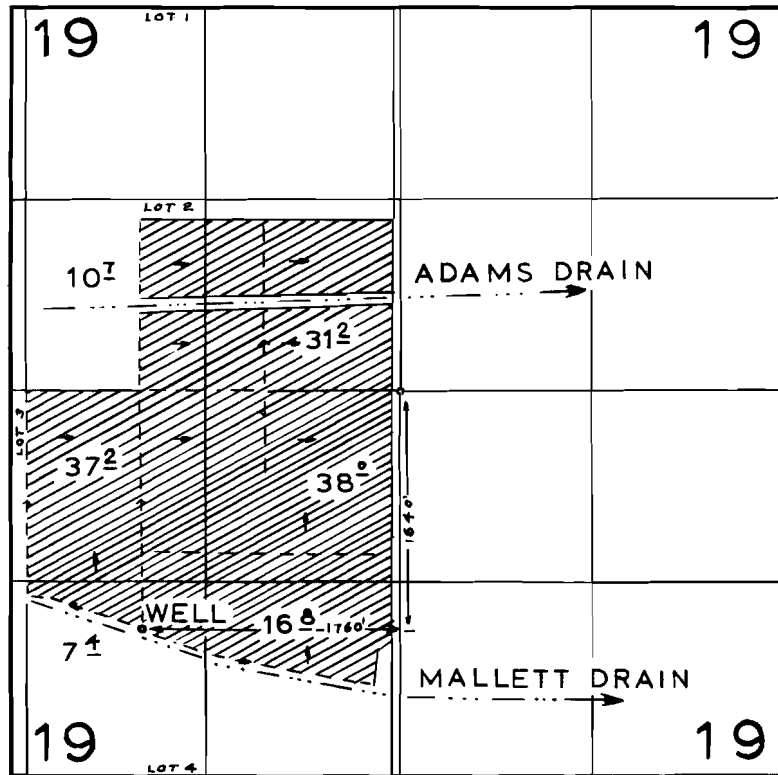

FINAL PROOF SURVEY
UNDER

Application No. G-2082 Permit No. G-1912
IN NAME OF

GLEN L. HUTCHINSON

Surveyed OCT. 30 1967, by F.ELFERING