

OR-8  
App. 2/23/55

UNITED STATES DEPARTMENT OF AGRICULTURE  
Soil Conservation Service  
Oregon

G-2368  
34668

LOCATION OF A.C.P. PRACTICES  
Program Year \_\_\_\_\_

Operator \_\_\_\_\_


A.C.P. Farm No. \_\_\_\_\_

County \_\_\_\_\_

Section 10 Township 19S Range 44 EWM Aerial Photo No. \_\_\_\_\_

8" = 1 Mile

GREEN LINES ARE DITCHES

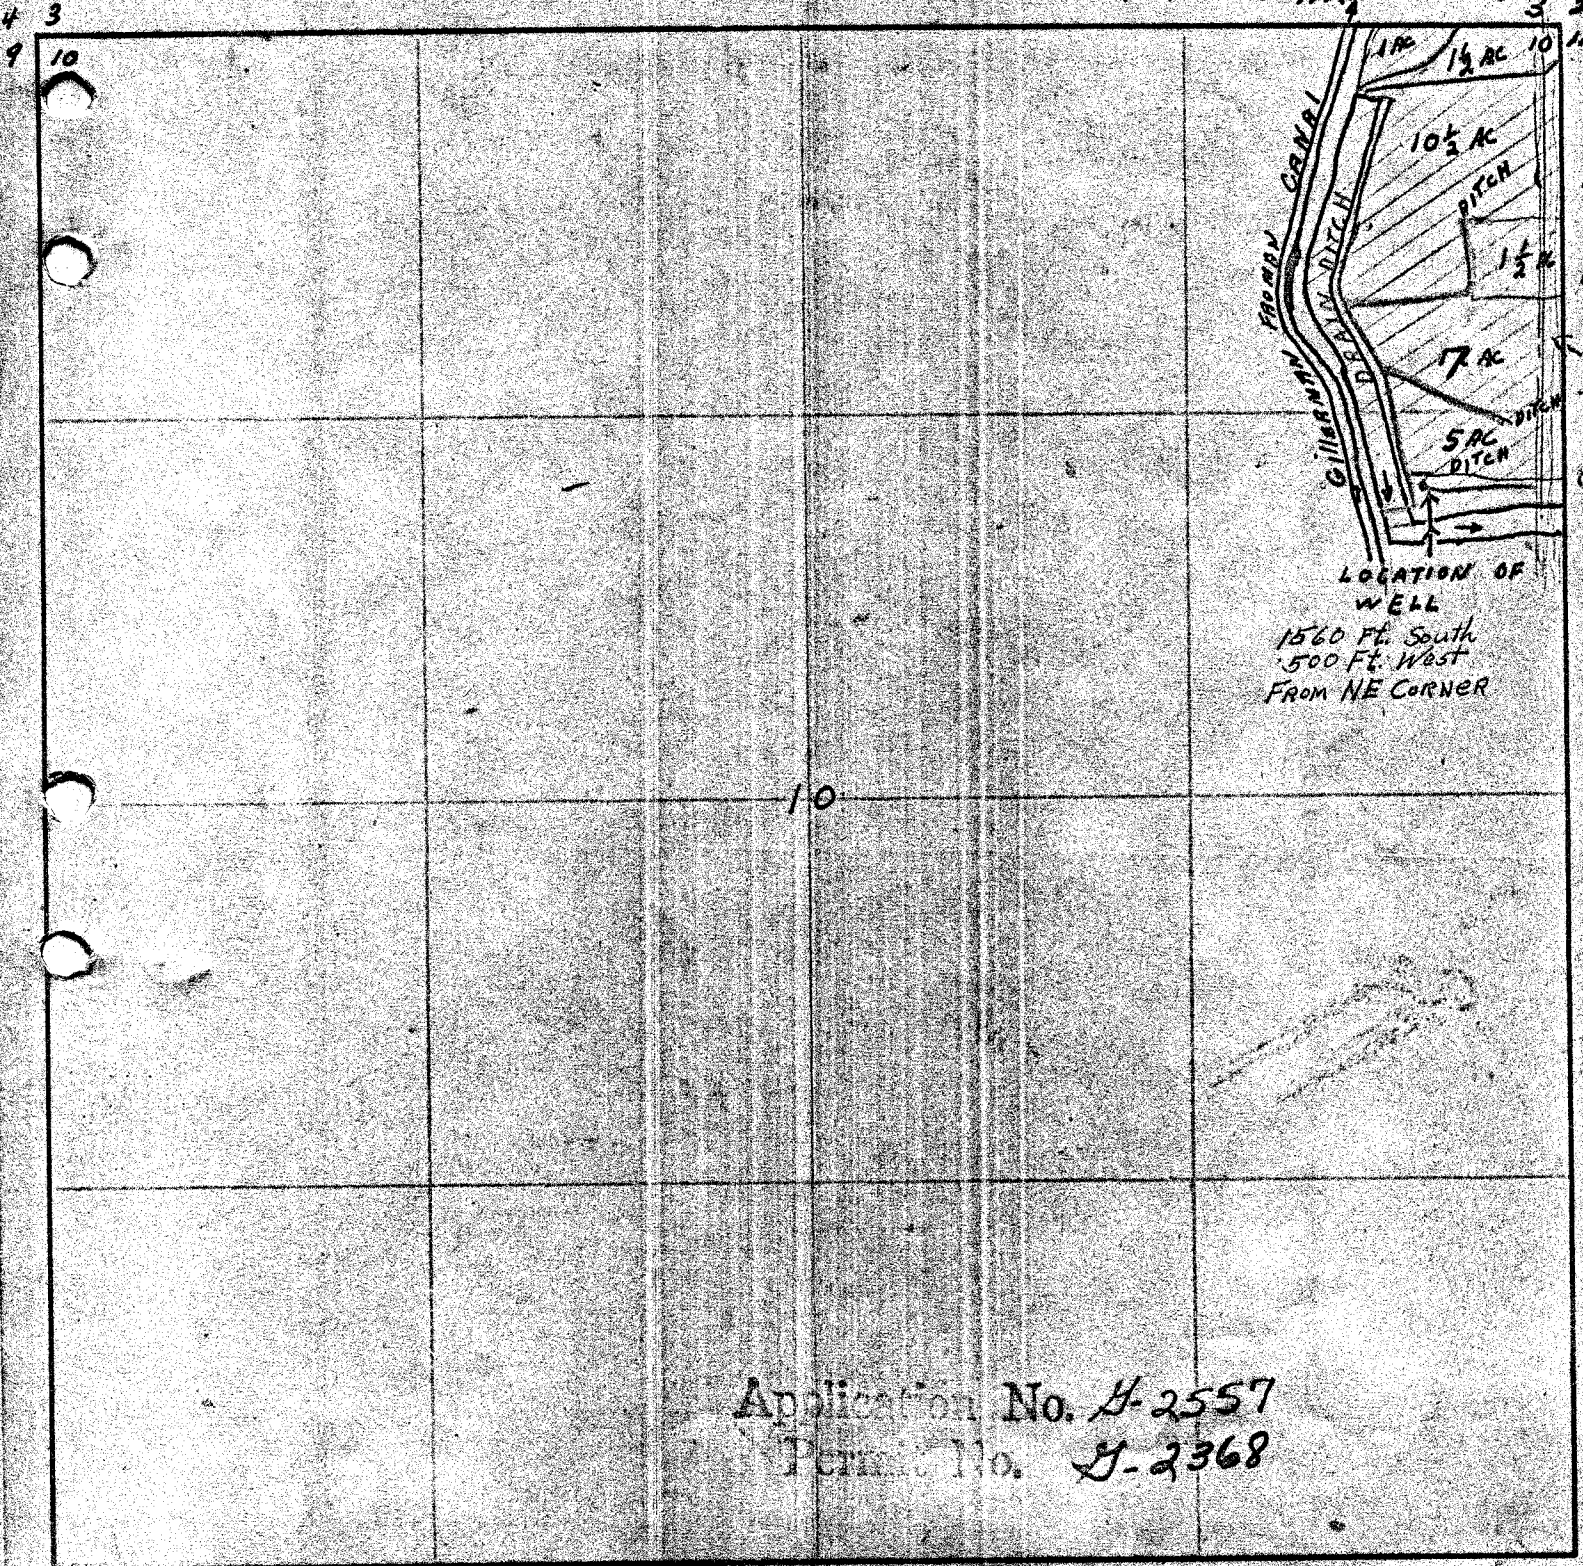

Application No. H-2557

Permit No. G-2368