


T.18 S.R.47 E.W.M.

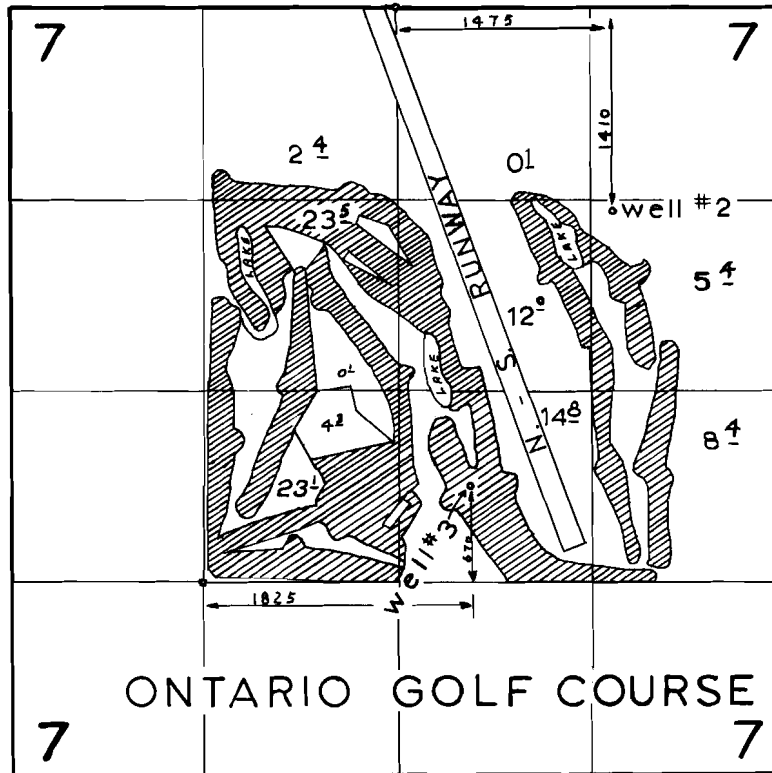

**FINAL PROOF SURVEY**  
UNDER

Application No. G-2792 Permit No. G-2616  
IN NAME OF

CITY OF ONTARIO

Surveyed NOV.16, 1967, by F.ELFERING