


T.18 S.R. 47 E.W.M.

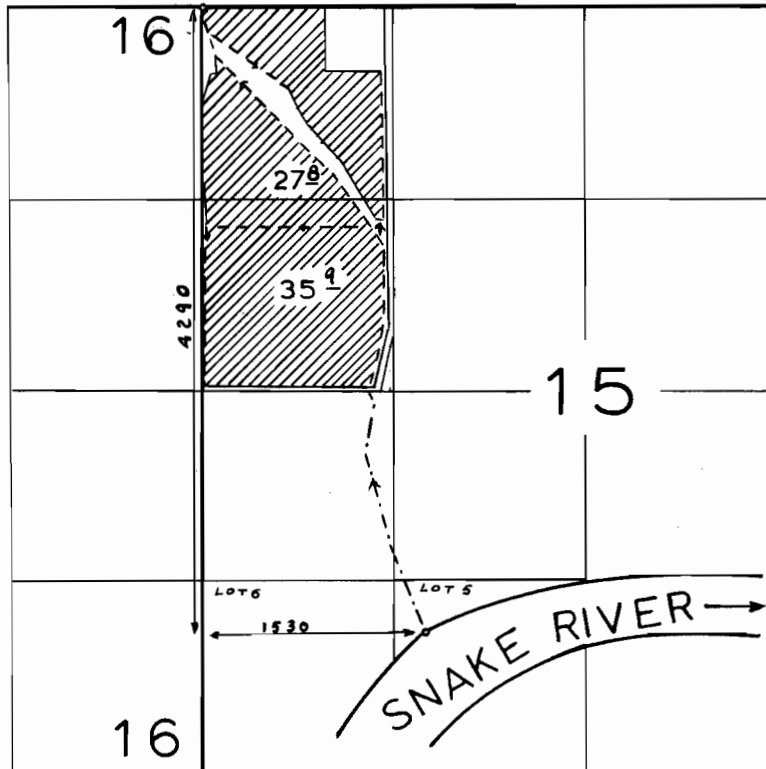

FINAL PROOF SURVEY
UNDER

Application No. 37002 Permit No. 27642
IN NAME OF

CLYDE O. BOSTON

Surveyed MARCH 5 1966, by F. ELFERING