


T.18S.R.46E.W.M.

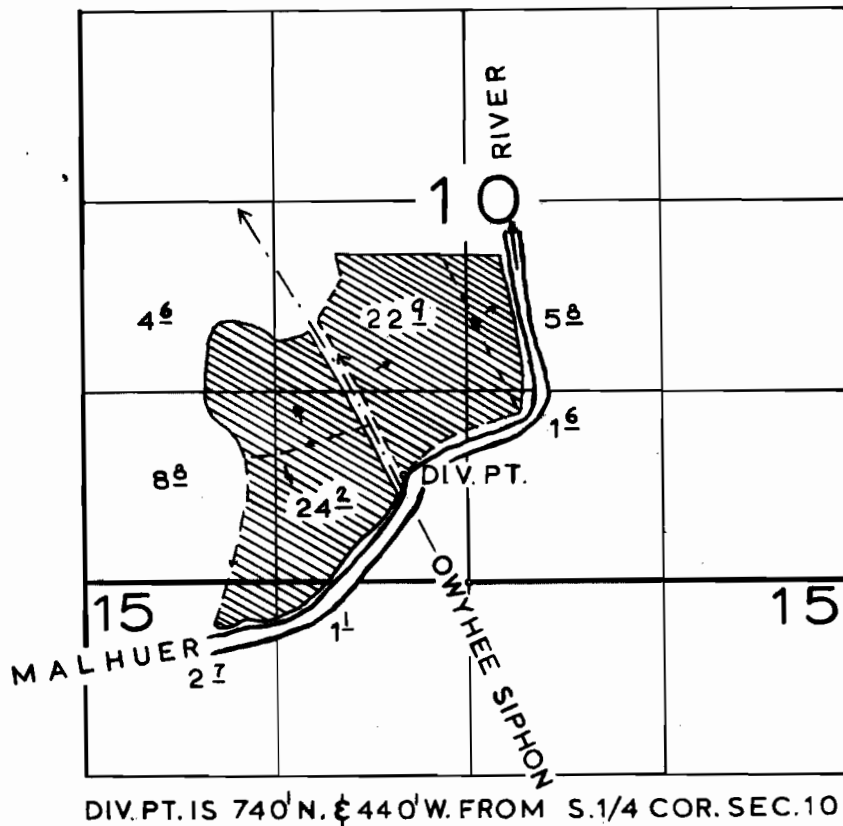


FINAL PROOF SURVEY
UNDER

Application No. 34978 Permit No. 27698
IN NAME OF

WESLEY AND GERTRUDE BLANTON

Surveyed OCT. 18, 1967, by F. ELFERING

T. 18 S. R. 46 E. W. M. .

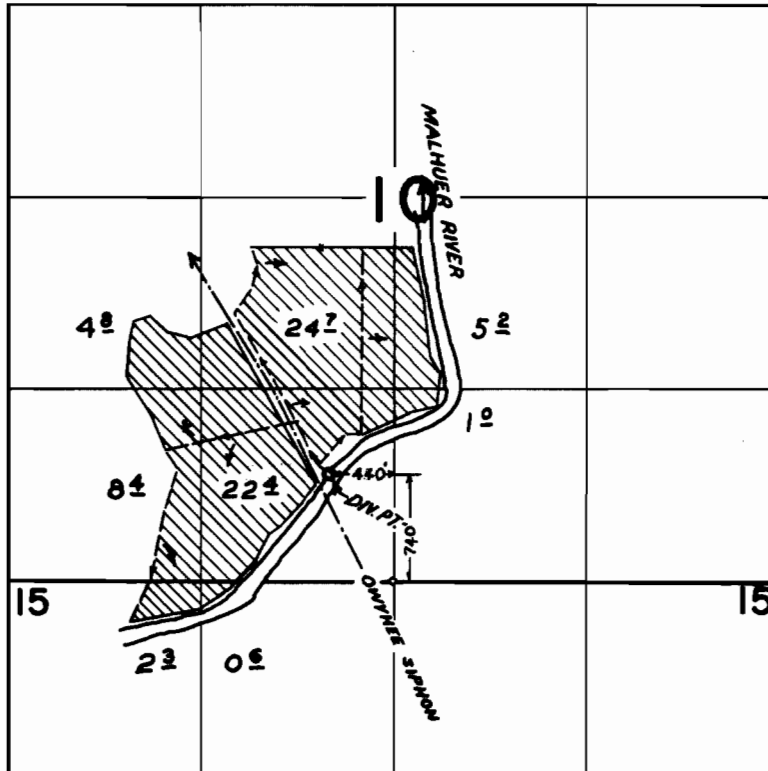

FINAL PROOF SURVEY
UNDER

Application No. 34978 Permit No. 27698
IN NAME OF

Wesley and Gertrude Blanton

Surveyed Oct. 9, 1965, by C. GARDNER