


T. 18 S. R. 45 E. W.M.

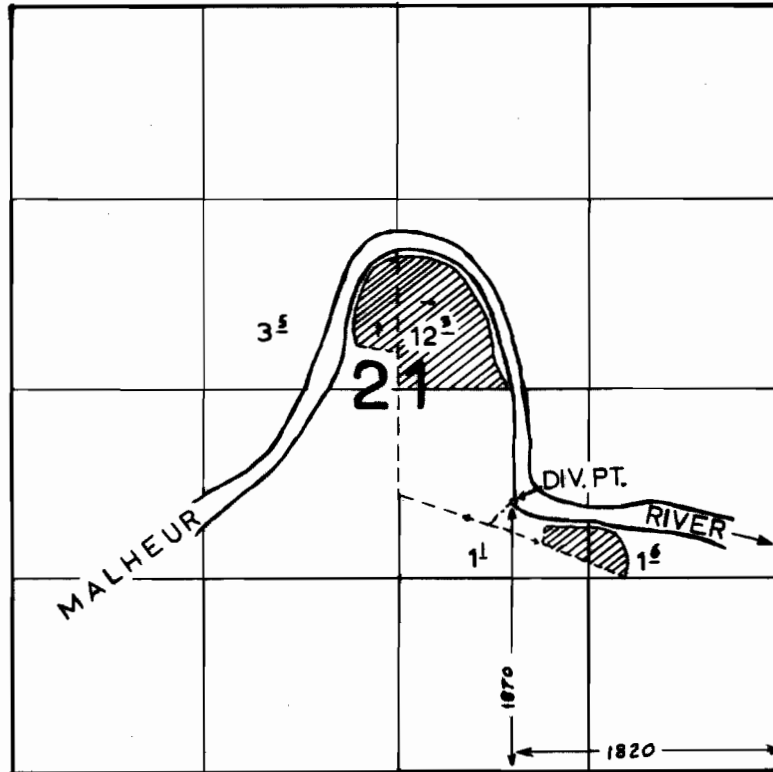

FINAL PROOF SURVEY
UNDER

Application No. 4141B..... Permit No. 30936...

IN NAME OF

CLAUDE SHEARER

Surveyed OCT. 31... 1967., by FELFERING...