


T. 4 S. R. 1 W. W. M.

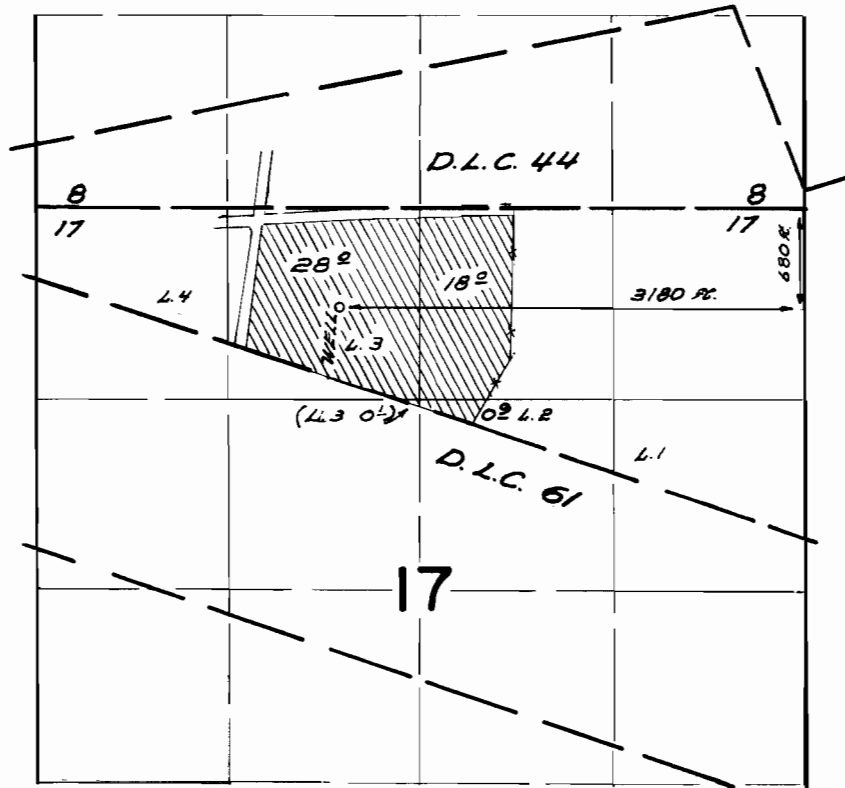

FINAL PROOF SURVEY UNDER

Application No. G-2447 Permit No. G-2266
IN NAME OF

Carl E. Oslund

Surveyed May 3, 1967, by W. J. Ruppert