


T. 5 S. R. 1 W. WM.

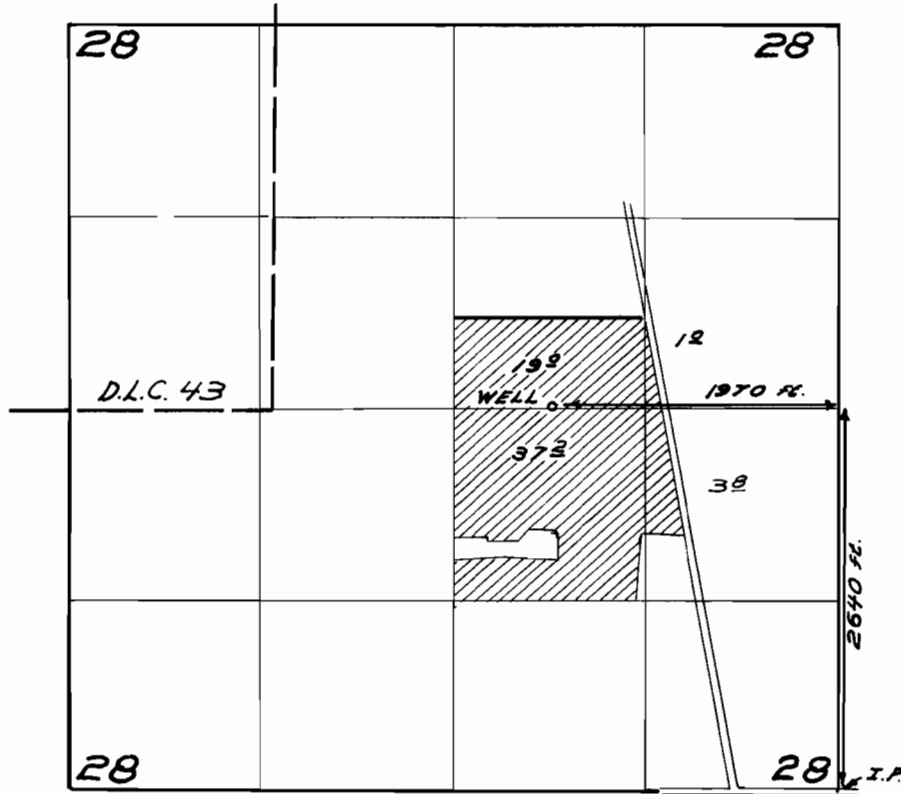

FINAL PROOF SURVEY
UNDER

Application No. G-2472 Permit No. G-2285
IN NAME OF

Alfred Juve

Surveyed Sept 6 1966, by W.J. Ruppert