


# T.6S. R.2W.W.M.

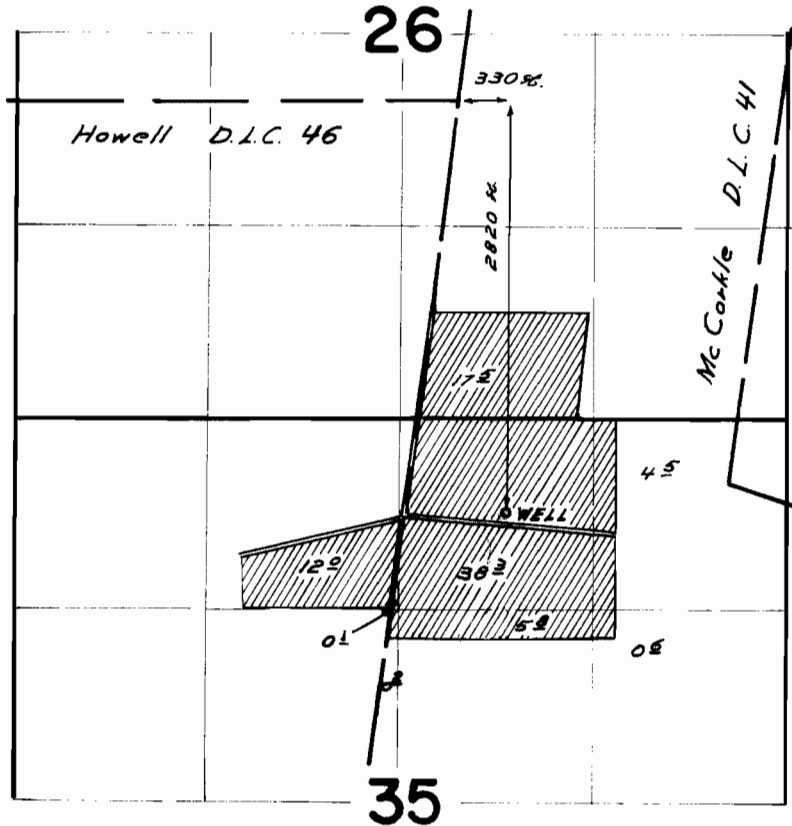

## FINAL PROOF SURVEY UNDER

Application No. G-2544 Permit No. G-2355  
IN NAME OF

Richard Tuve

Surveyed 9-28 1966, by W. J. Ruppert