


T.6S. R.2W. W.M

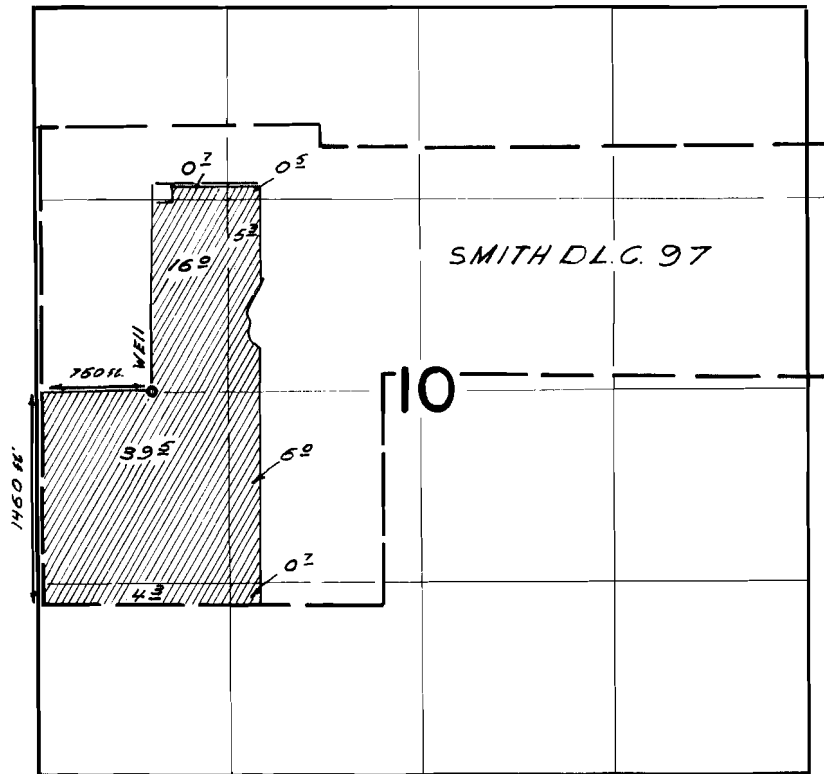

FINAL PROOF SURVEY UNDER

Application No. G-2795 Permit No. G-2603
IN NAME OF

Harry A. Robinson

Surveyed Aug 19 1966 by W.J. Ruppert