


T.6S. R.2W.W.M.

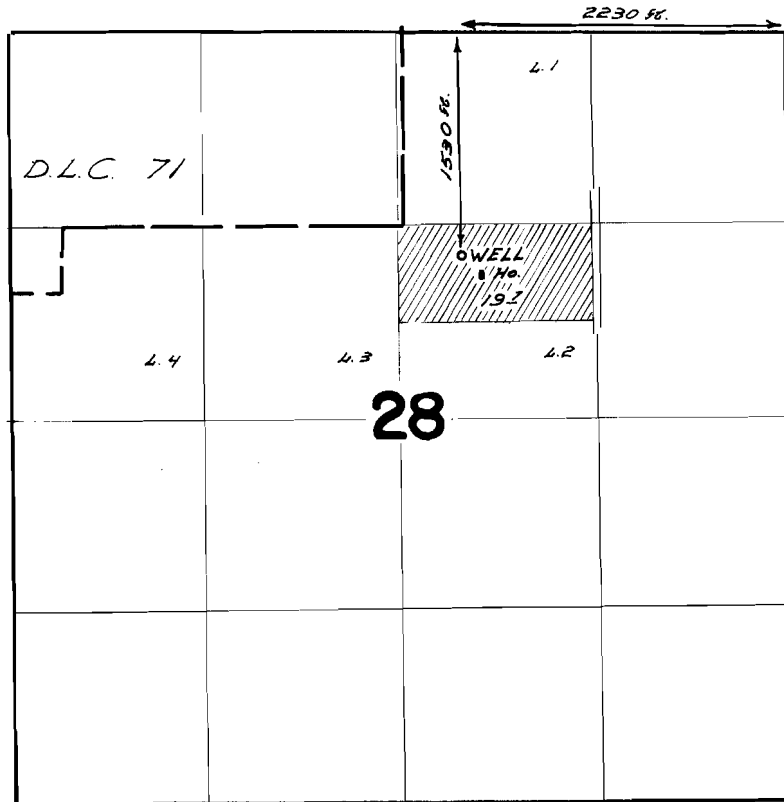

FINAL PROOF SURVEY UNDER

Application No. G2829 Permit No. G.2632
IN NAME OF

Jesse R. DeCair, Jr.

Surveyed Sept 28 1966, by W.J. Ruppert