


T.5S.R.1W.W.M.

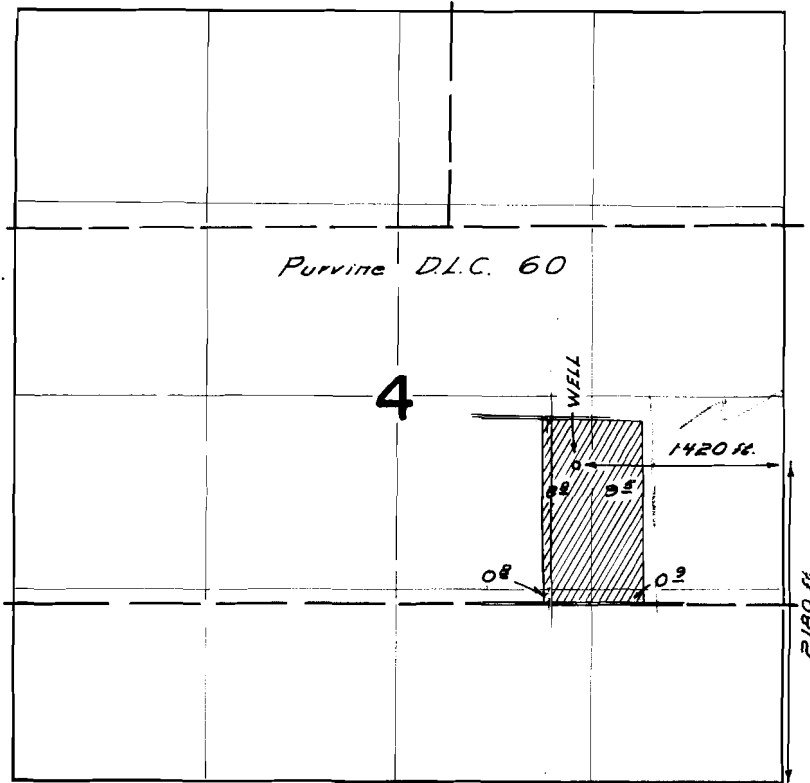

FINAL PROOF SURVEY
UNDER

Application No. G-2856 Permit No. G-2657
IN NAME OF

Chester Barstad

Surveyed Sept. 7, 1966 by N. J. Ruppert