


T.6S. R.1W. W.M.

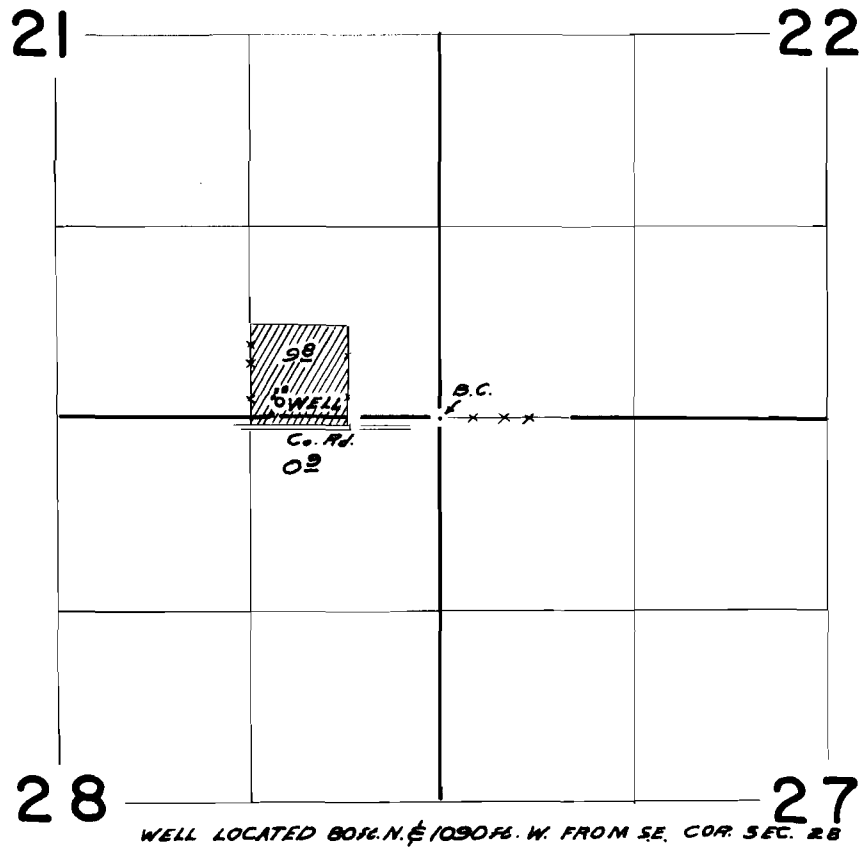

FINAL PROOF SURVEY
UNDER

Application No. G-2900 Permit No. G-2683
IN NAME OF

Clarence Predeck

Surveyed Sept 28 1966, by W. J. Ruppert