


T.6S. R.2W.W.M.

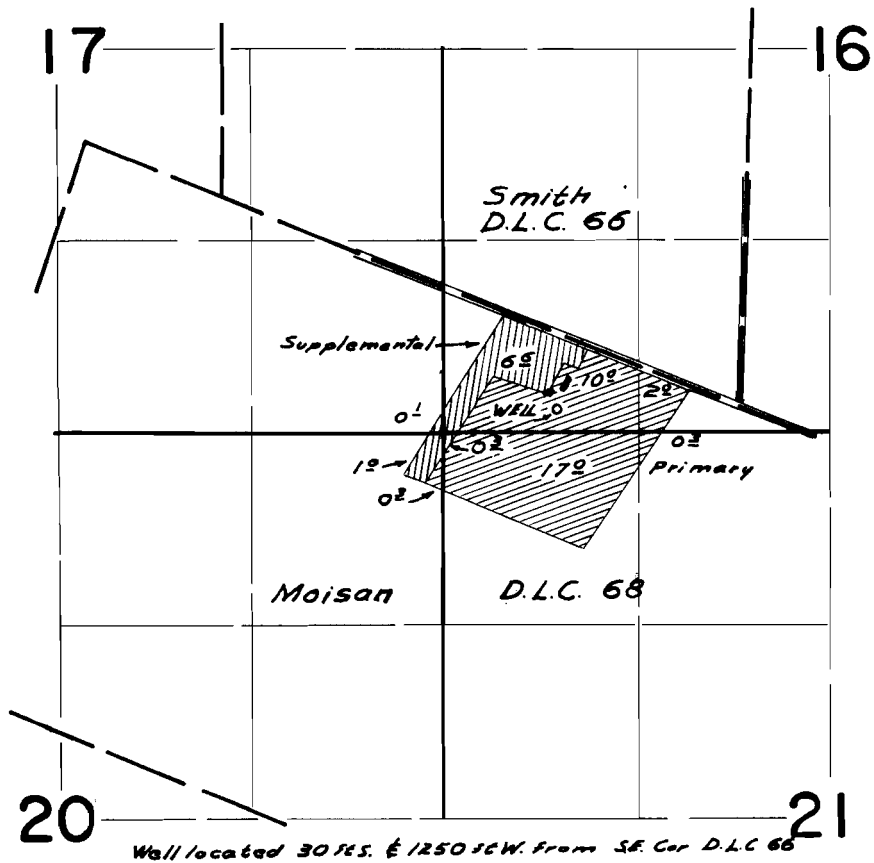

FINAL PROOF SURVEY
UNDER

Application No. G-3001 Permit No. G-2796
IN NAME OF

Maurice C. Nuytten

Surveyed Aug 16 1956, by W.J. Ruppert