


# T.6S. R.1E.W.M.

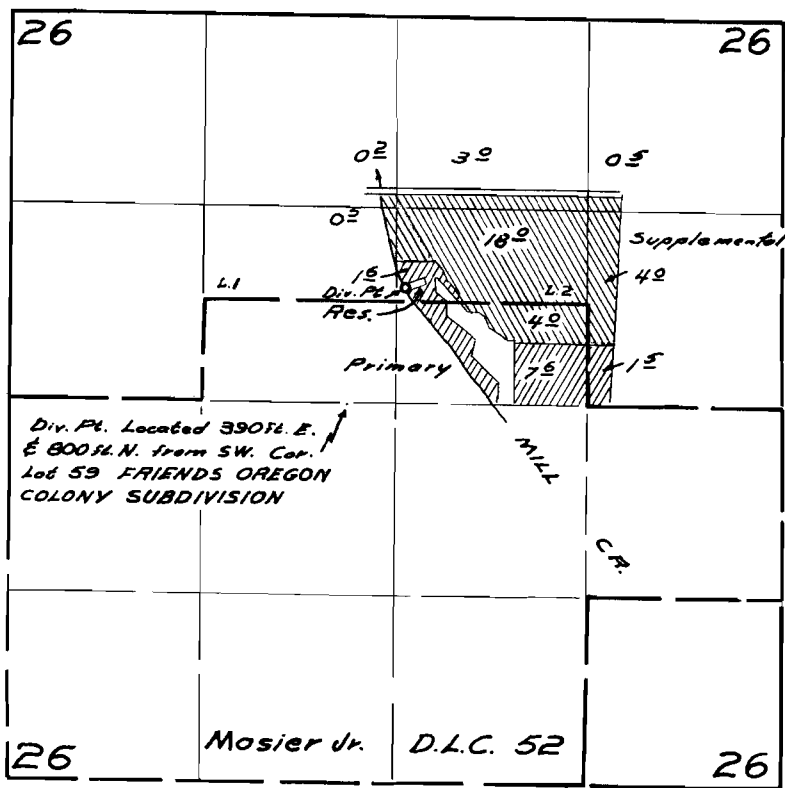

## FINAL PROOF SURVEY UNDER

Copy from

34184

27094

Application No. R-34525 Permit No. R-2569

IN NAME OF

Russell Nelson

Surveyed Sept 30 1966, by W. J. Ruppert