


T.6 S. R.1 E. W.M.

copy from
S-34843

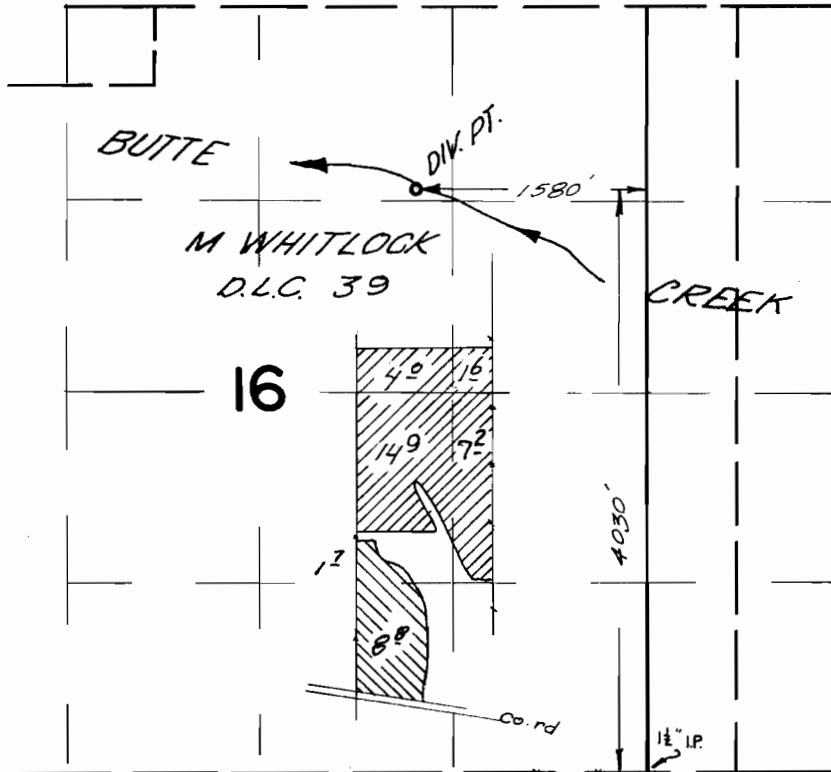

FINAL PROOF SURVEY
UNDER

34843 27352 
Application No. 37602 Permit No. 28042 
IN NAME OF

RICHARD D. HARRIS

Surveyed Aug. 16. 1966, by V. GARNER