


T.6 S. R.1 E. W.M.

copy from
S-34843

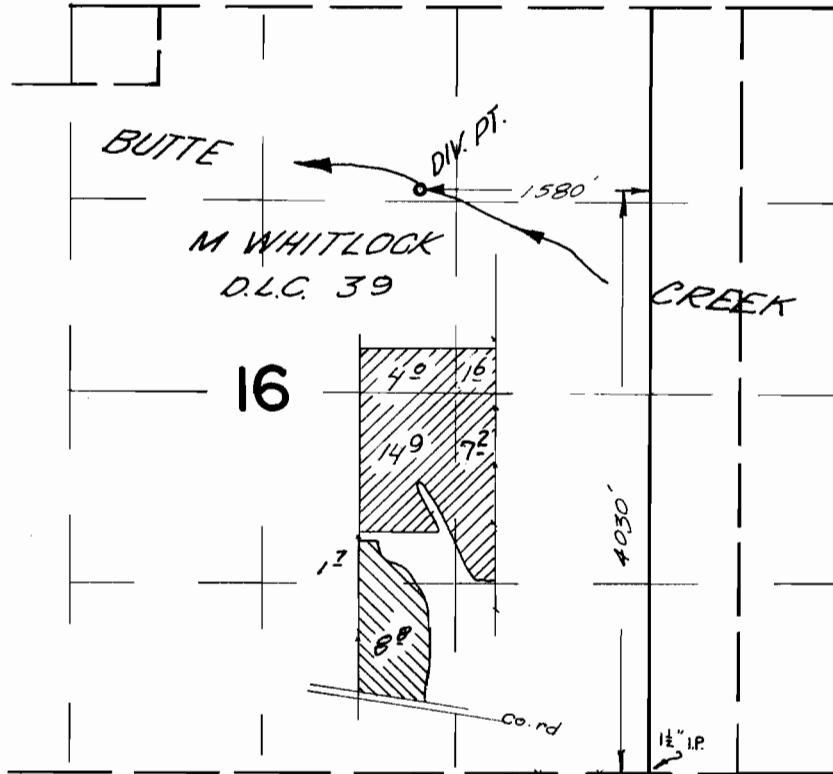

FINAL PROOF SURVEY UNDER

Application No. 34843 Permit No. 27352 
37602  IN NAME OF

RICHARD D. HARRIS

Surveyed Aug. 16, 1966, by V. GARNER