


T. 6 S. R. 1 W. W. M.

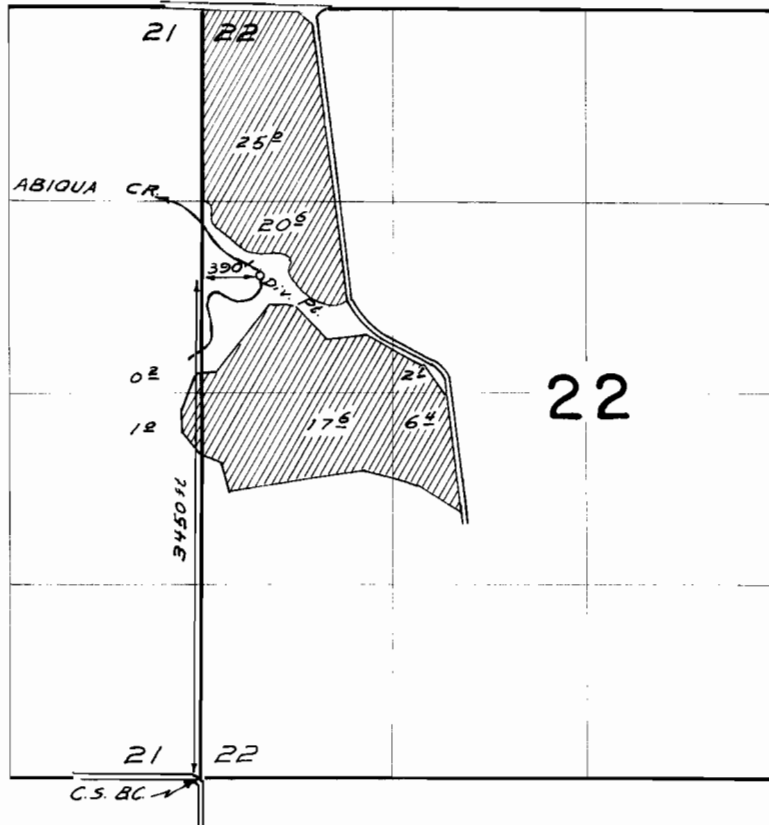

FINAL PROOF SURVEY UNDER

Application No. 37810 Permit No. 28157
IN NAME OF

Herman Goschie

Surveyed 8-16 & 18 1966, by W. J. Ruppert