


T.6S. R2&3.W. W.M.

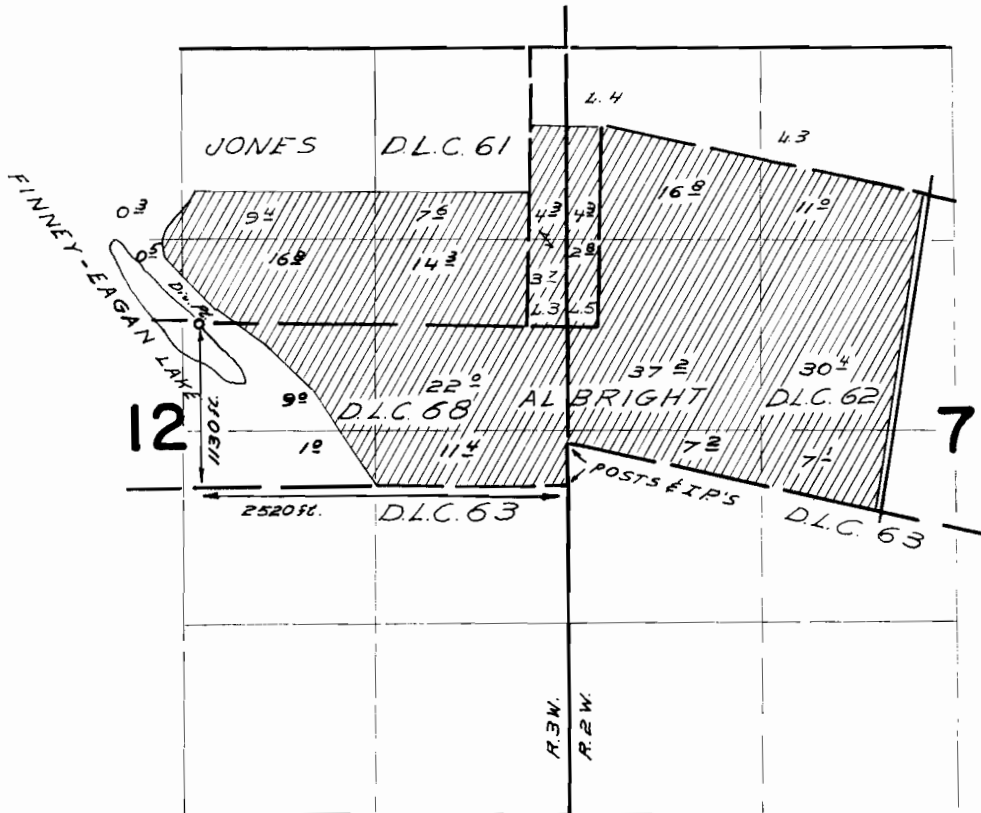

FINAL PROOF SURVEY UNDER

Application No. 37957 Permit No. 28372
IN NAME OF

Fred or Marie Zielinski

Surveyed Sept 30, 1966, by W. J. Ruppert