


T.6S. R.1E.W.M.

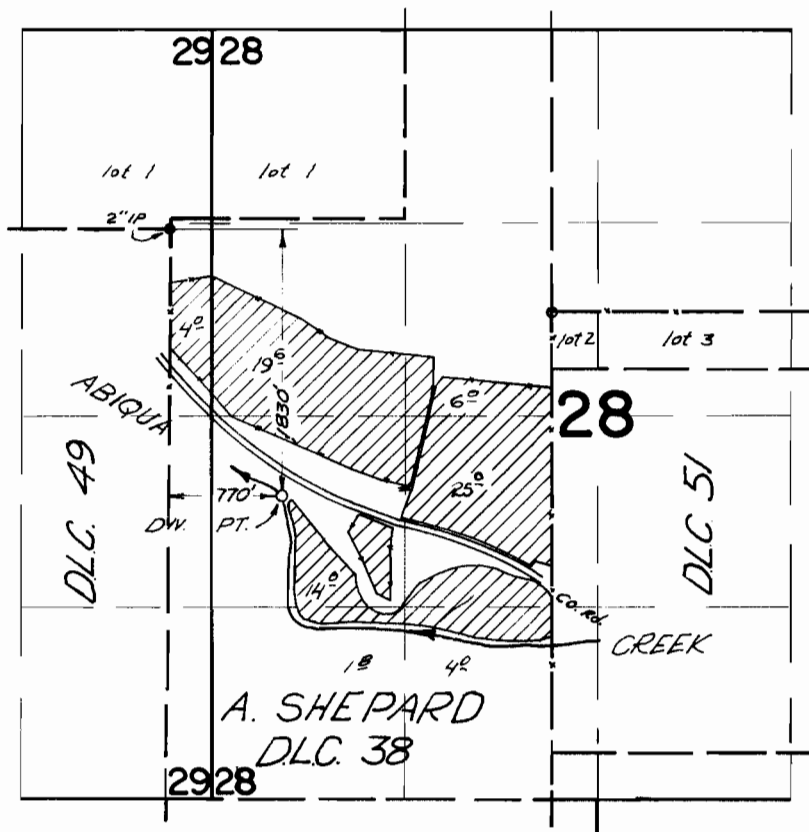

FINAL PROOF SURVEY UNDER

Application No. 38781 Permit No. 28850
IN NAME OF

WILLIAM F. FESSLER

Surveyed Nov. 27, 1967, by V. Garner