


T.6S. R.2W. W.M.

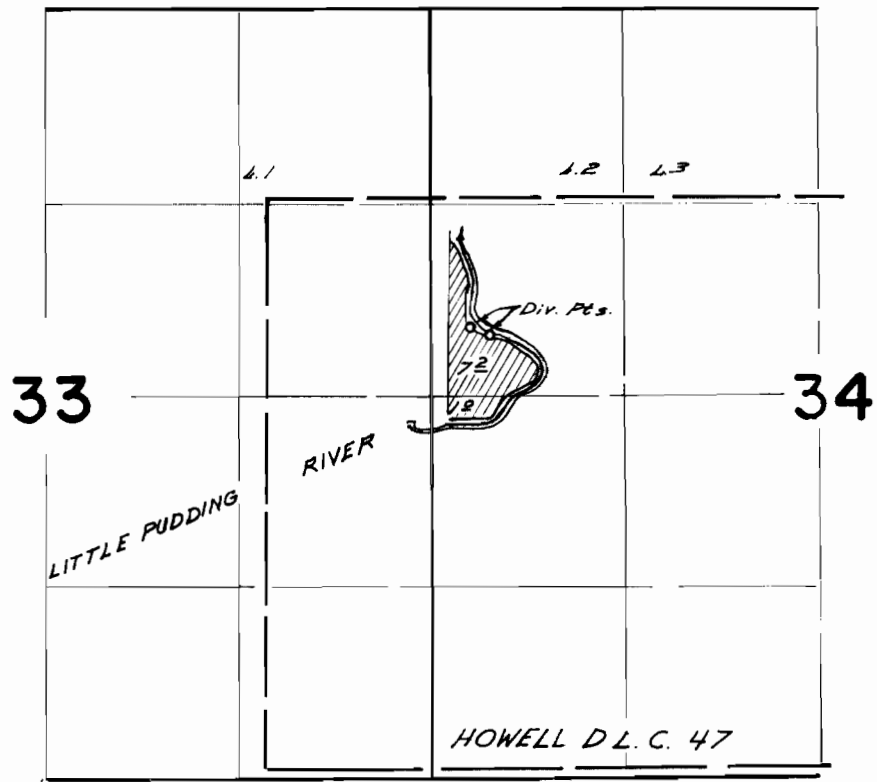

Div. Pts. Located 2180 P.S. & 2890 P.S.; & 2240 P.S. & 3020 P.S. E. from N¹/₄ Cor. Sec. 33.

FINAL PROOF SURVEY UNDER

Application No. 38805. Permit No. 28859
IN NAME OF

Charles E. Howell

Surveyed Sept 27 1966, by W. J. Ruppert