


T. 5S. R. 1W. W.M.

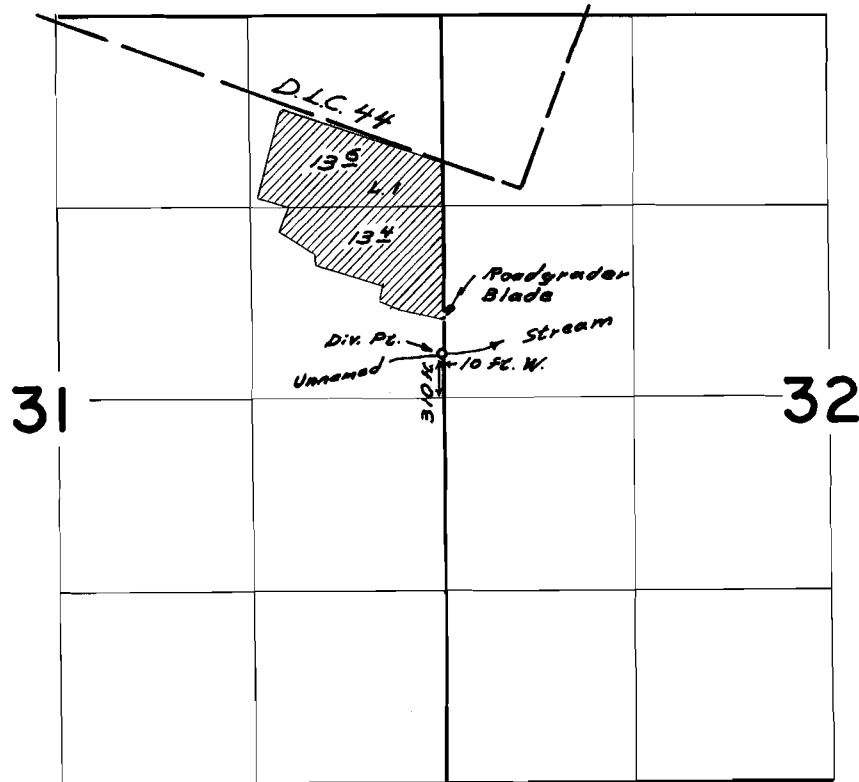

**FINAL PROOF SURVEY**  
UNDER

Application No. 40550 Permit No. 30222  
IN NAME OF

Andrew Eder

Surveyed Sept. 9, 1966, by W.J. Ruppert