


T.3S. R.24E.W.M.

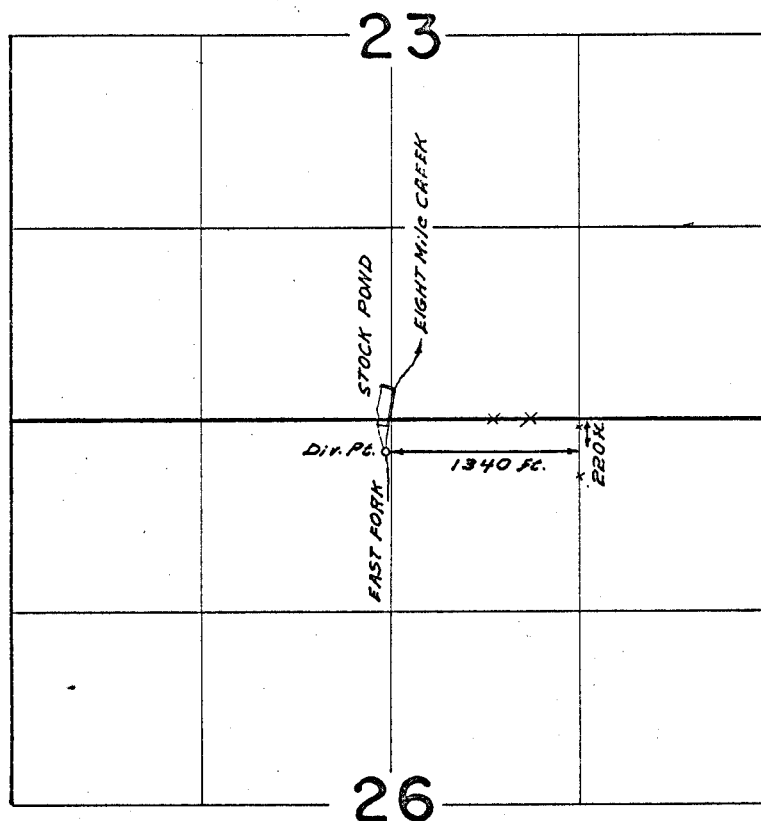

FINAL PROOF SURVEY
UNDER

Application No. R-34478 Permit No. R-2561
IN NAME OF

L. H. Rill

Surveyed June 24 1966, by W. J. Ruppert