


T4S. R.25E.W.M.

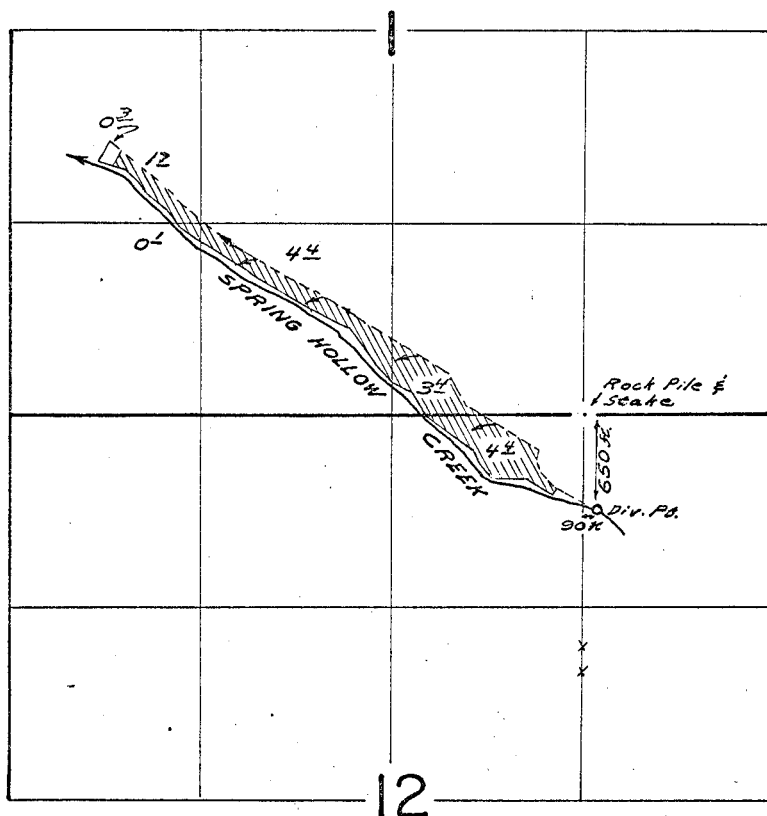

FINAL PROOF SURVEY
UNDER

Application No. 38026 Permit No. 28341
IN NAME OF

Orian E. Wright

Surveyed June 26 1966, by W. J. Ruppert