


T.1S. R.3E.W.M.

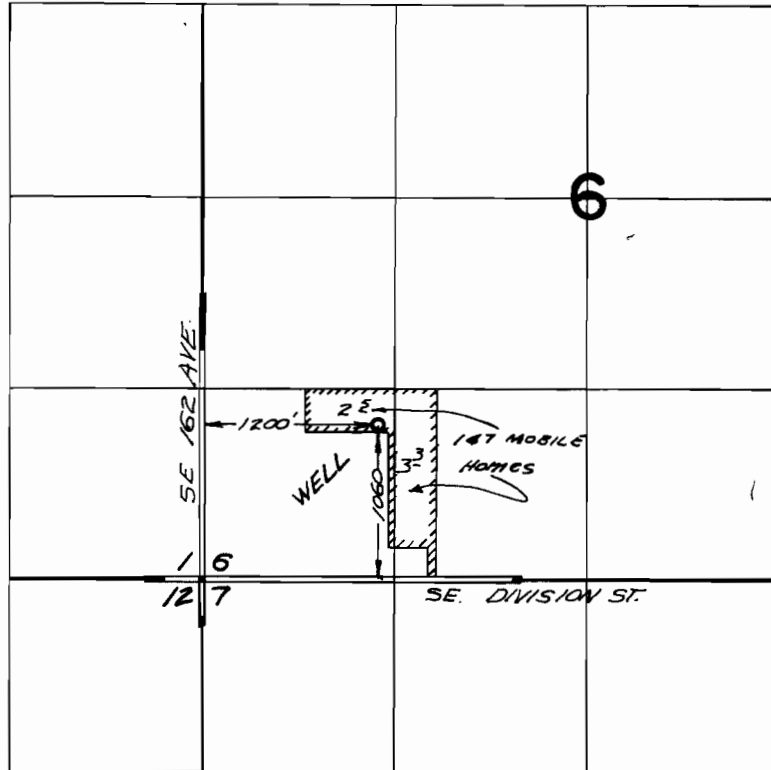

FINAL PROOF SURVEY UNDER

Application No. G-2130 Permit No. G-2240
IN NAME OF

MOBILE ESTATES CORPORATION

Surveyed Sept. 2, 1966, by V. GARNER.