


T.1N. R.3E. W.M.

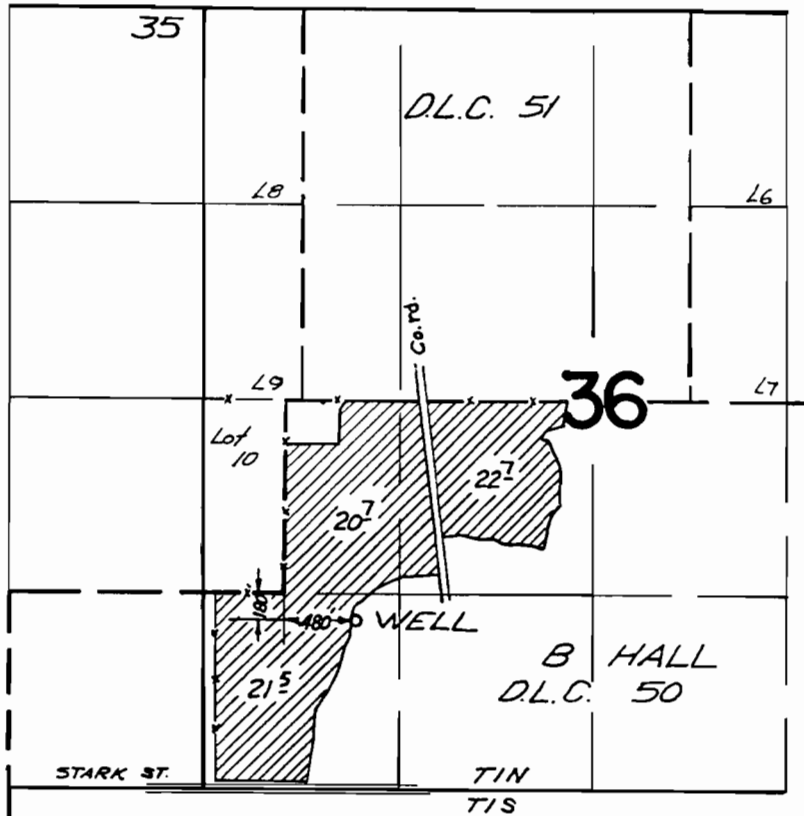

FINAL PROOF SURVEY UNDER

Application No. G-2512. Permit No. G-2320
IN NAME OF

JAMES M. FUJII

Surveyed Sept. 1, 1966, by V. GARNER...