


T.1N.8IS.R.4E.W.M.

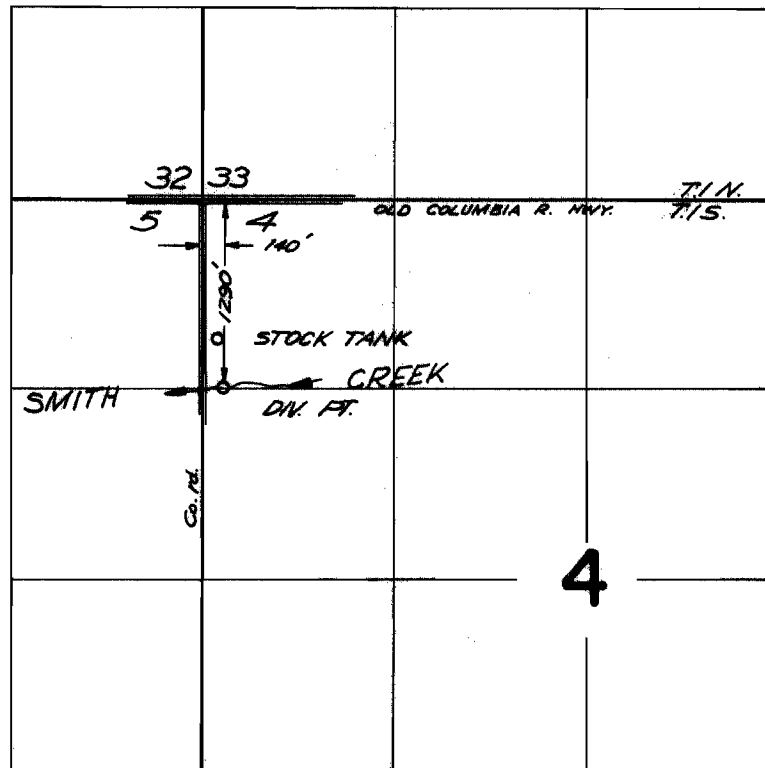

FINAL PROOF SURVEY
UNDER

Application No. 33967 Permit No. 26776
IN NAME OF

RICHARD W. STARK

Surveyed Aug. 29, 1966, by V. GARNER