


T.1S.R.5E.W.M.

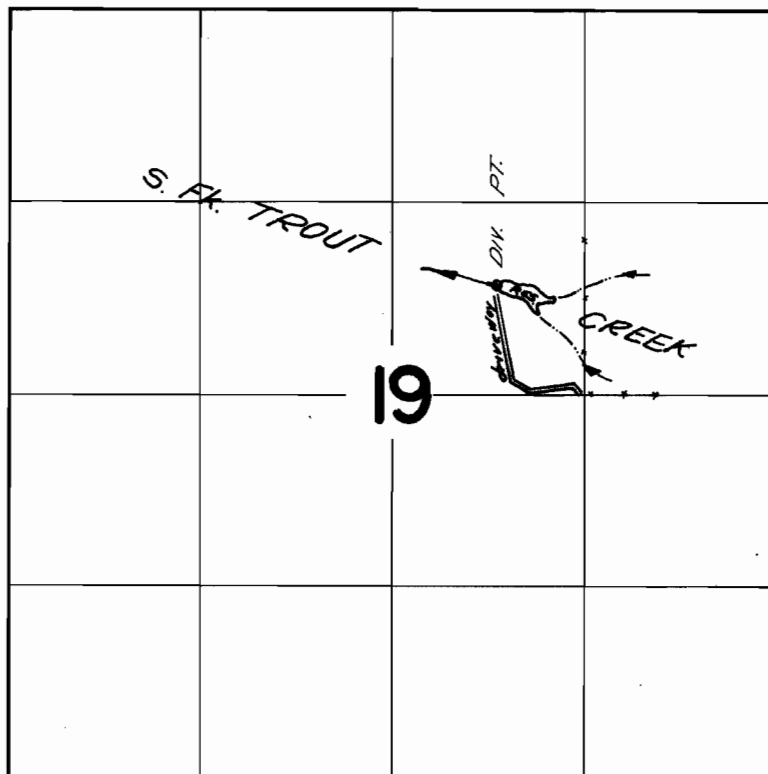

Div. pt located 740 ft. N. and 600 ft. W.
from the SE cor. SW $\frac{1}{4}$ NE $\frac{1}{4}$, Sec. 19

FINAL PROOF SURVEY
UNDER

R 37850 R 3136
Application No. 38019 Permit No. 28336
IN NAME OF

HOWARD L. ROSS

Surveyed Aug. 31, 1966 by V. GARNER