


T. 7 & 8 S. R. 4 W. W.M.

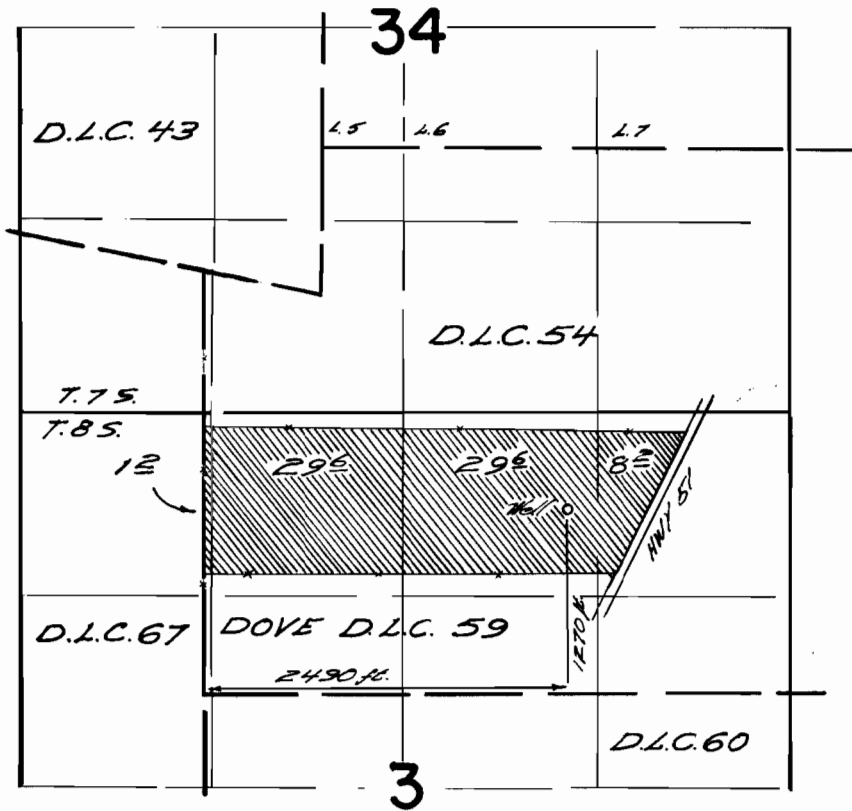

FINAL PROOF SURVEY
UNDER

Application No. G-2338 Permit No. G-2198
IN NAME OF

Theodore Muller

Surveyed April 15, 1966, by *W.C. Ruppert*