


T. 7 S. R. 4 W. W.M.

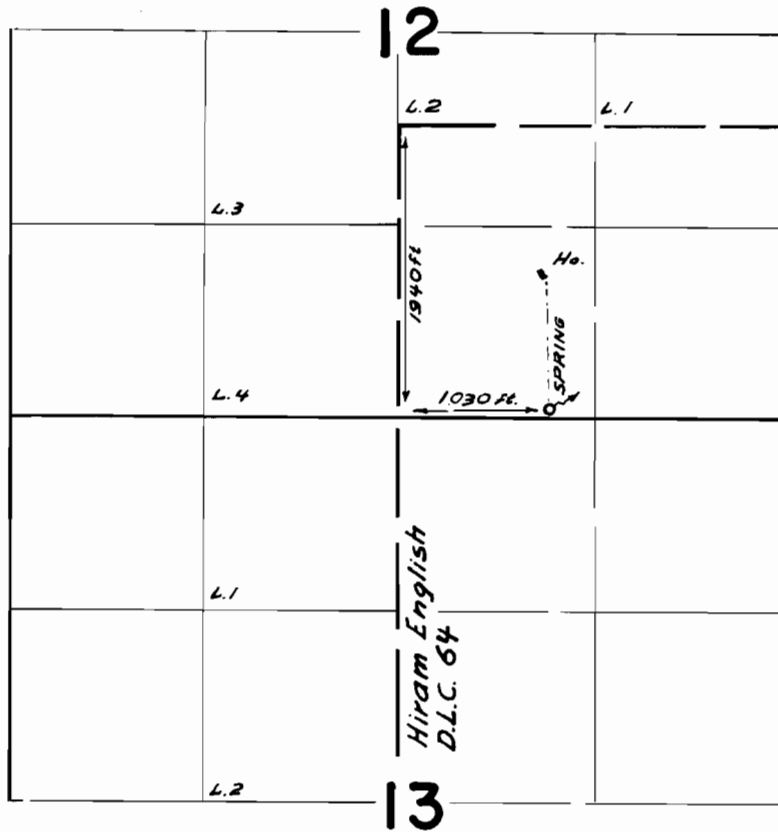

FINAL PROOF SURVEY
UNDER

Application No. 37437 Permit No. 27875
IN NAME OF

FRANK W. MOORE

Surveyed SEPT. 7 1966, by W.J. Ruppert