


T. 6 & 7 S. R. 4 & 5 W. W.M.

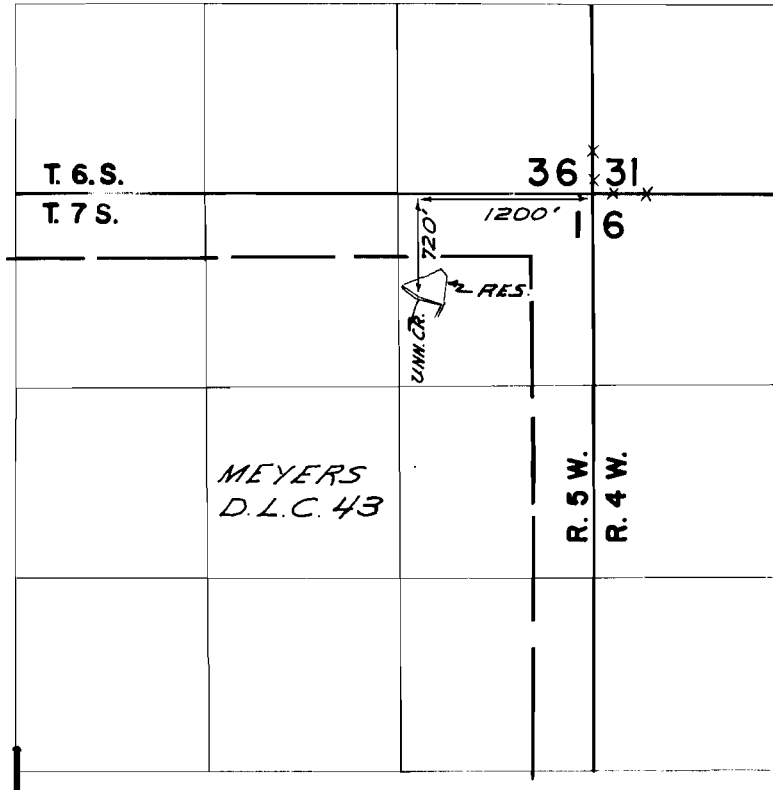

**FINAL PROOF SURVEY**  
UNDER

Application No. R-41155 Permit No. R-4623  
IN NAME OF

C. E. WAINWRIGHT

Surveyed APR. 25 1966, by *W. J. Ruffert*