


T.6S. R.6W. W.M.

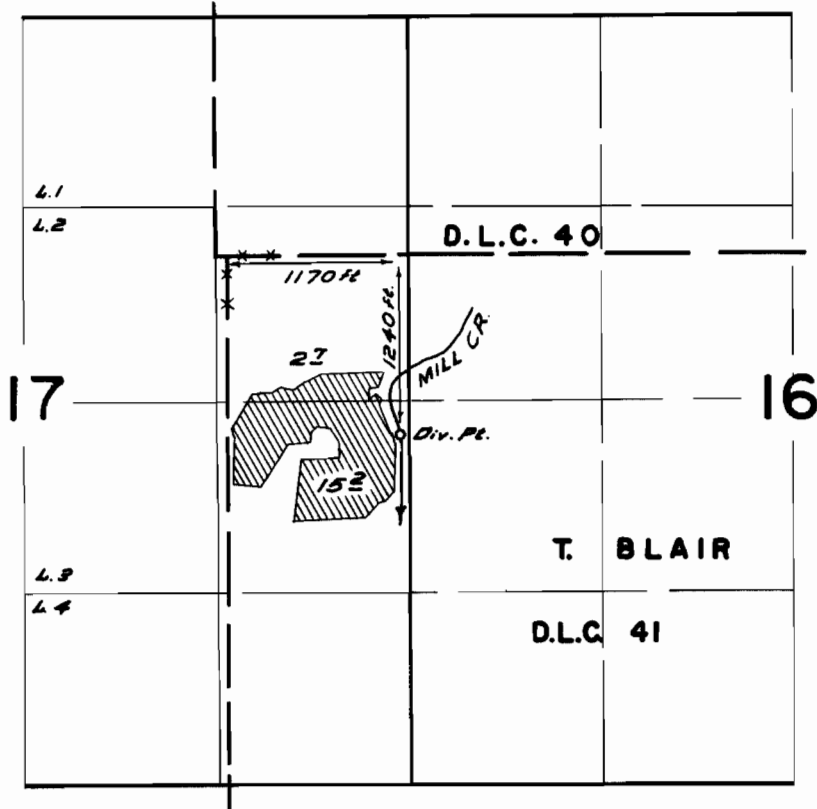

FINAL PROOF SURVEY
UNDER

Application No. 37612... Permit No. 28052.
IN NAME OF

..... W. B. KENOYER

Surveyed APR. 26 1966, by *V. J. August*