


T. 7 S. R. 5 W. W. M.

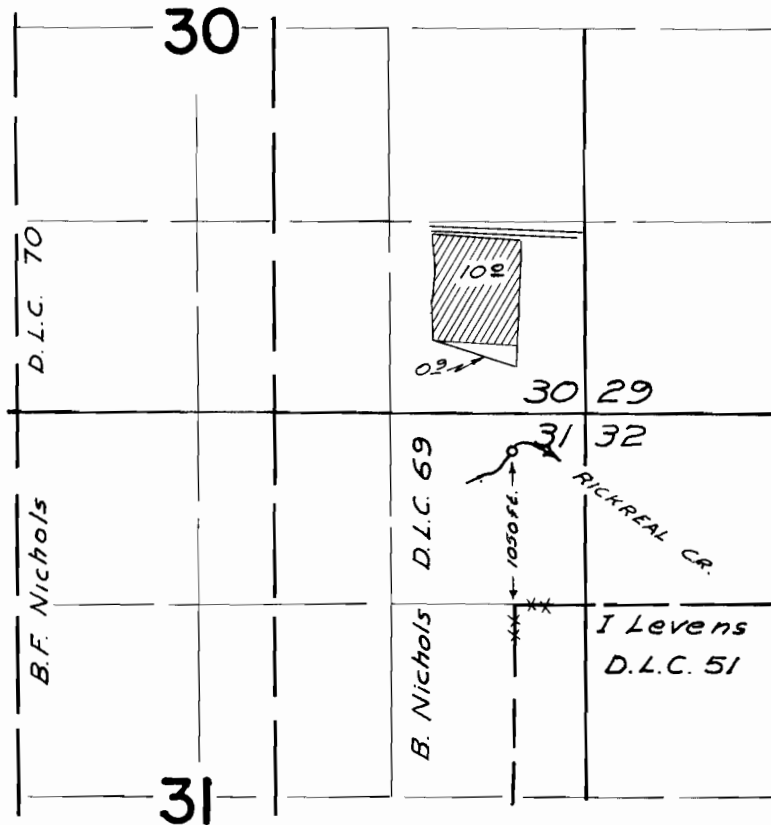

FINAL PROOF SURVEY
UNDER

Application No. 39423 Permit No. 29378
IN NAME OF

W. B. MORLAN

Surveyed APR 27 1966, by W. J. Ruppert