


T. 9S. R. 6 W. W. M.

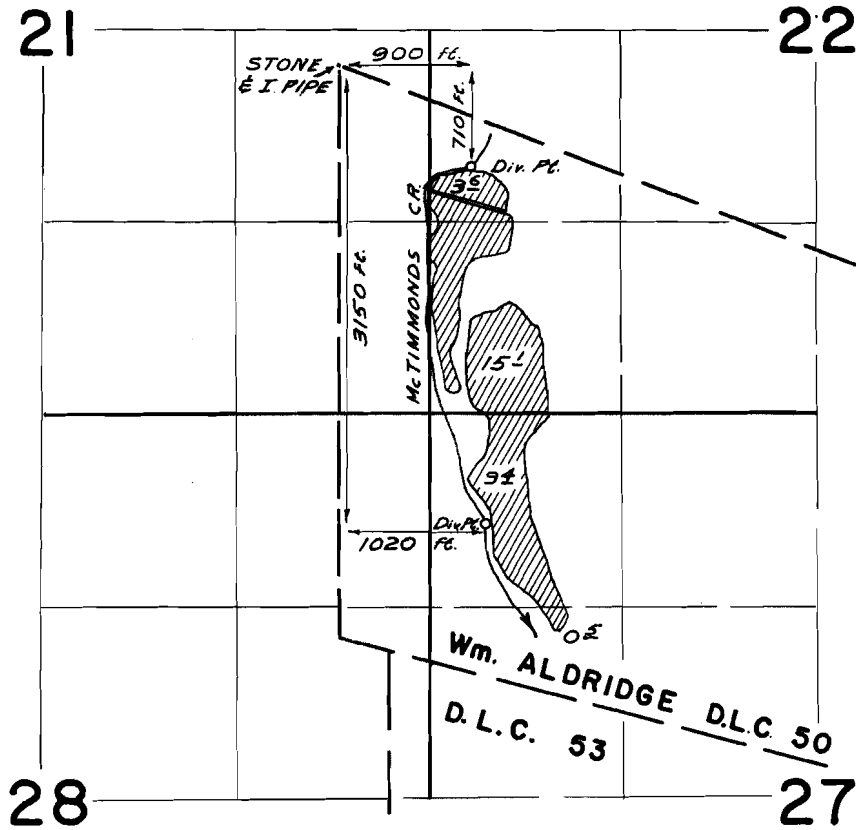

FINAL PROOF SURVEY
UNDER

Application No. 40.7.9.3. Permit No. 3.0.3.9.6
IN NAME OF

PAUL W. BROWN & JOHN M. WHITE

Surveyed JULY 27 1966., by *H. J. August*