


T.9.S. R.6W.W.M

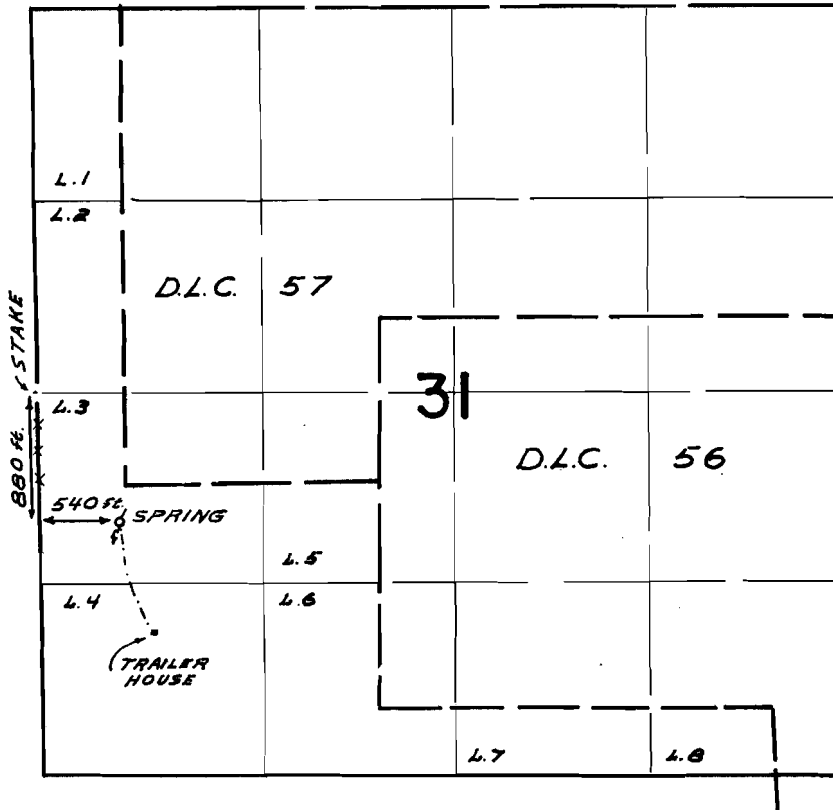

FINAL PROOF SURVEY UNDER

Application No. 40808 Permit No. 30404
IN NAME OF

F. W. Head

Surveyed July 27 1966, by W. J. Ruppert