


T.6S. R.6W. W.M.

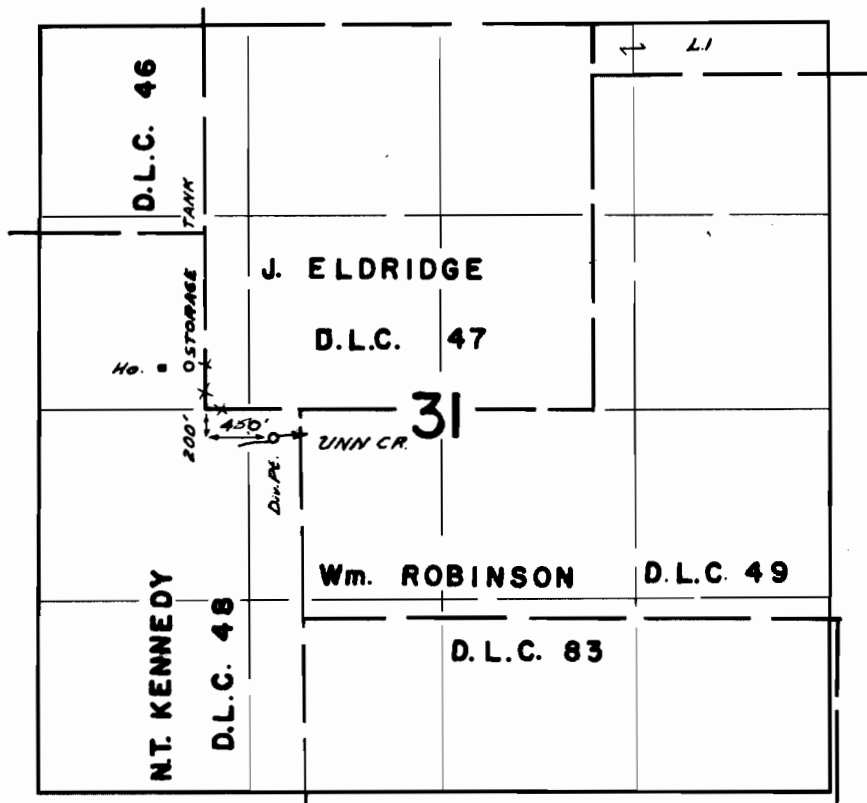

FINAL PROOF SURVEY UNDER

Application No. 41160..... Permit No. 30685...
IN NAME OF

MATTHEW WORRIX

Surveyed APR. 29 1966., by *W. J. [Signature]*