


T.2 N. R.18E. W.M.

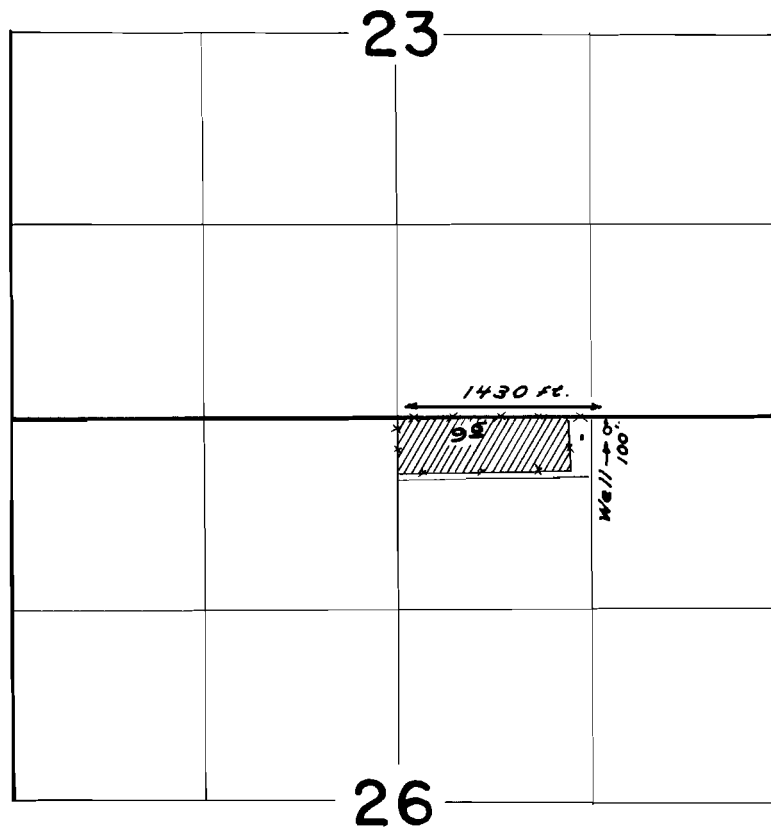

FINAL PROOF SURVEY
UNDER

Application No. G-2056 Permit No. G-1940
IN NAME OF

Kenneth N. Fridley

Surveyed June 20 1966, by N.J. Ruppert