


# T.5&6 N. R.35 E. W.M.

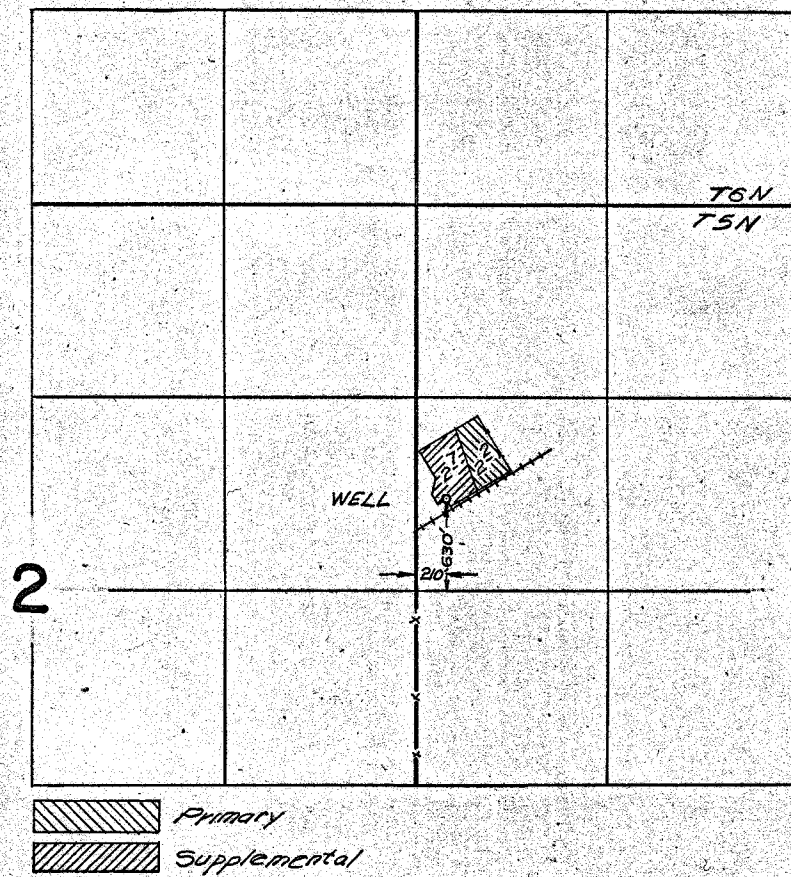

## FINAL PROOF SURVEY UNDER

Application No. G-2885 Permit No. G-2725  
IN NAME OF

CARL R. and SUE E. STEWART

Surveyed Oct. 26, 1966, by V. GARNER