


T.I.S.R.2W.W.M.

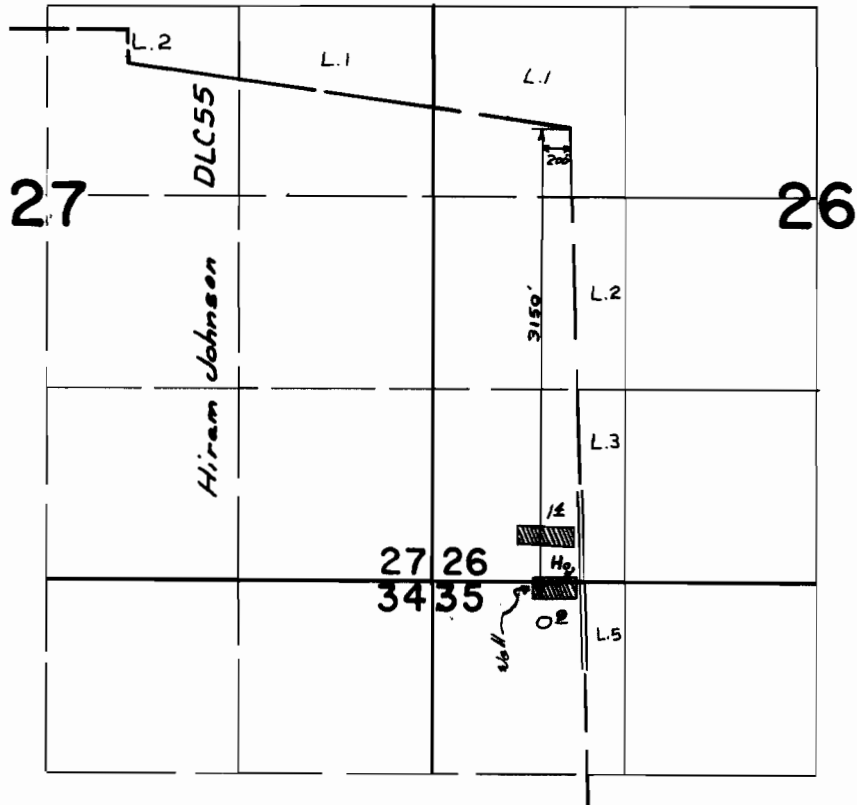

FINAL PROOF SURVEY UNDER

Application No. G-2530 Permit No. G-2345
IN NAME OF

Alfred B. Oekerman

Surveyed Aug. 15 1967, by W. J. Ruppert