


T.6 N. R.35 E. W.M.

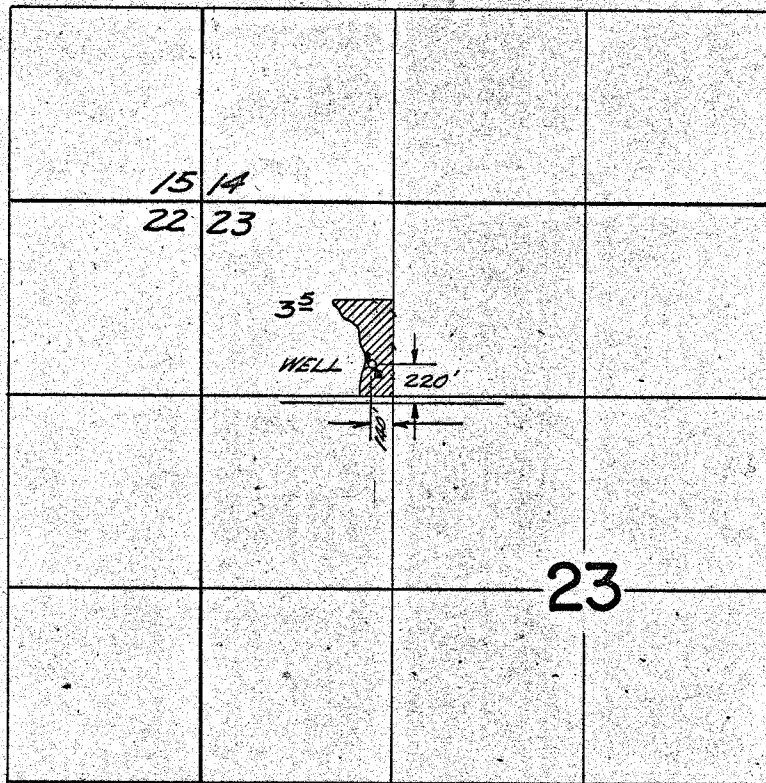

FINAL PROOF SURVEY UNDER

Application No. G-2854... Permit No. G-2900...
IN NAME OF

.....ROSS E. HINTON.....

Surveyed Oct. 26.. 1966, by V. GARNER..